

Wayne

P-70

6-16-80

6/16/80

MISSISSIPPI BOARD OF WATER COMMISSIONERS 416 North State Street Jackson, Mississippi 39201

CODED

WATER WELL DRILLERS LOG

1980 C.P. Clark Water Wells 1 Wipre

date well completed

firm name

county well located

LANDOWNER: Ron Moody
Wagnersboro, Miss.

(mailing address)

WELL LOCATION:

sec. 30 T 8 N R 5 E
1 3/4 miles S of Denham
(distance) (direction) (nearest town)

WELL PURPOSE:

home (home, irrigation, municipal, industrial)

description of formations encountered

from to

Red clay	0	14
Loose sand, cre	14	76
Sandy clay	76	86
sand	86	95
Clay w/ hard and soft streaks	95	115
Sand	115	121
Clay and sdy clay	112	143
Rock streaks	143	167
Clay	167	246
Wicksburg limestone	246	77

WELL COMPLETION DATA:

- (1) diameter (inches) 2
- (2) total depth (feet) 272
- (3) static water level (feet) 17' below top of ground.
- (4) casing: Galv, 247
(material) (depth)
- (size) If telescope see back.
- (5) screen none,
(length) (depth to top)
- (size) (material)
- (6) pump 1/2 10 1/2
(HP) (yield gpm)
- 220V 1φ
(type power)
- (7) electric log no
(yes or no)
- (organization running log)
- (8) how well bottom plugged none

CODED

DEPT. OF NATURAL RESOURCES BUREAU OF LAND & WATER RESOURCES


JUL -3 1980

RECEIVED

DRILLERS REMARKS:

If well telescopes please sketch and show depths.

GROUND LEVEL

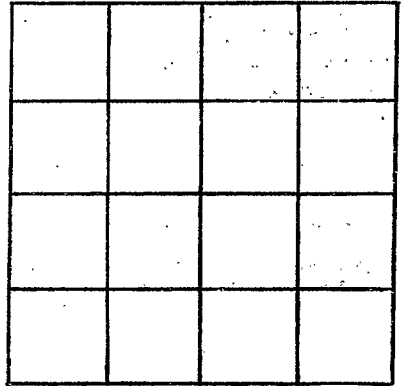

SECTION _____

Please indicate well location X.

ADDITIONAL INFORMATION

If more than one screen, show locations of each on sketch.