

MISSISSIPPI  
BOARD OF WATER COMMISSIONERS  
416 North State Street  
Jackson, Mississippi 39201

WATER WELL DRILLERS LOG

CODED

1  
P-71  
7-3-80


7-3-80, *Shiner Drilling* *Wayne*  
date well completed firm name county well located

LANDOWNER:	description of formations encountered	from	to
<i>Madine Oil Corp.</i>	<i>sand</i>	<i>0</i>	<i>21</i>
<i>Two Allen Center</i>	<i>chalk and rock</i>	<i>21</i>	<i>147</i>
<i>Suite 630</i>	<i>chalk</i>	<i>147</i>	<i>252</i>
<i>Houston, TX 77002</i>	<i>chalk, streaked</i>	<i>252</i>	<i>336</i>
WELL LOCATION: <i>155°N 85°E</i>	<i>sand, chalk</i>	<i>336</i>	<i>357</i>
<i>sec. 5, T. 8, R. 5</i>	<i>chalk, rock</i>	<i>357</i>	<i>441</i>
<i>of</i>	<i>streaked</i>	<i>441</i>	<i>567</i>
<i>McCluskey, Wayneboro</i>	<i>chalk</i>	<i>567</i>	<i>588</i>
WELL PURPOSE: <i>oil field supply</i>	<i>streaked, lime</i>	<i>588</i>	<i>714</i>
(home, irrigation, municipal, industrial)	<i>rock</i>		
WELL COMPLETION DATA:			
(1) diameter (inches) <i>3"</i>			
(2) total depth (feet) <i>714'</i>			
(3) static water level (feet) <i>150'</i> below top of ground.			
(4) casing <i>steel, 441'</i> (material) (depth)			
<i>3"</i> (size) if telescope see back.			
(5) screen <i>set well</i> (length) (depth to top)			
<i>open ended</i> (size) (material)			
(6) pump <i>70</i> (HP) (yield gpm)			
<i>ac</i> (type power)			
(7) electric log (yes or no)			
(organization running log)			
(8) how well bottom plugged <i>orange</i>			
<i>sell</i>			
DRILLERS REMARKS:			

DEPT. OF NATURAL RESOURCES  
BUREAU OF LAND & WATER RESOURCES  
JUL 18 1980  
RECEIVED

If well telescopes please  
sketch and show depths.

GROUND LEVEL

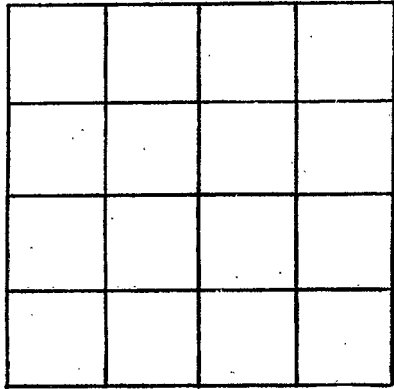

SECTION \_\_\_\_\_

Please indicate well location X.

ADDITIONAL INFORMATION

If more than one screen,  
show locations of each on sketch.