

STATE WELL REPORT

201

County: Wayne
 Permit #: 5496
 Driller: Earl Mosley
 Date drilling completed: 1-6-20

Part 1
Driller's Log
 Mississippi Department of Environmental Quality
 Office of Land and Water Resources
 P.O. Box 2309
 Jackson, MS 39225-2309
 (601)961-5555
 (601)961-5228 (fax)

For Office Use Only:

Well #: P 92
 Aquifer: _____
 E-Log #: _____

State Law requires that this report be prepared by the license holder responsible for the work and filed with the Department at the above address within 30 days of completion of drilling of the well or borehole.

Well Owner Information (Landowner if borehole is not for a water well)	Well or Borehole Location
Owner Name: <u>JASON COOLEY</u>	Latitude: <u>31-679</u> Longitude: <u>88-503</u>
Mailing Address: <u>MARTIN SUNLIGHT</u>	Method of Lat/Long (check one): Conventional Survey _____, USGS quad _____, Hand-held GPS <u>X</u> , Survey-grade GPS _____
<u>Waynesboro MS 39307</u>	<u>SW</u> ^{NE} <u>1/4</u> <u>NE</u> <u>1/4</u> , Sec <u>8</u> T <u>8N</u> R <u>5E</u>
City _____ State _____ Zip Code _____	<u>10</u> Miles <u>EAST</u> of <u>Waynesboro</u>
Telephone No. (<u>601</u>) <u>310 2402</u>	(Distance) (Direction) (Nearest Town)

Well / Borehole Data
Date drilling started: <u>1-5-20</u> Date drilling completed: <u>1-6-20</u> Hole depth: <u>105</u> Hole diameter: <u>4"</u>
Location of the source of any surface water used for drilling: <u>837 COUNTY LAKE DEATHAM RD</u>
Method of dosing and volume of Chlorine used in drilling and development: <u>402 HTA</u>
Logs run (check all applicable): ☐ log run ☐ Electric ☐ Gamma Ray ☐ Density ☐ Sonic ☐ Neutron Other: <u>N/A</u>
Name of organization running log(s): <u>N/A</u>
Purpose of borehole (check one): Water Well ☒ Geotechnical/Geological Investigation ☐ Ground Source Heat Pump ☐ Seismic Survey Other (describe) _____
<i>If drilling is not related to water well construction, skip the remainder of this block</i>
Purpose of Well (check all applicable): ☐ Home ☐ Industrial ☐ Public Supply ☐ Irrigation ☐ Fish Culture Other (describe): <u>CAMP</u>
If a flowing well, method of flow regulation: Valve _____ Other (describe) _____
Static Water Level: <u>42</u> feet ☐ above or ☒ below land surface Date measured: <u>1-6-20</u> (check one)
Method of measurement (check one) ☒ Steel tape ☐ Electric tape ☐ Air line ☐ Other (describe): _____
Well depth: <u>105</u> Well grouted to a depth of: <u>10</u> feet Type of grout (check one) ☒ Heat Cement ☐ Bentonite ☐ Mix
Casing length: <u>75</u> feet Casing diameter: <u>4"</u> inches Type of casing: <u>PVC</u>
Screen length: _____ feet Screen diameter: _____ inches Type of screen: _____
Screen slot size: <u>Open</u> inches Setting depth: From <u>75</u> feet to <u>105 Open</u> feet
Type of completion (check all applicable) ☐ gravel packed ☐ Underreamed ☒ Open hole ☐ Natural Development
Other (describe): _____
Top of lap pipe or reduction in casing: _____ feet
<i>If telescoped or more than one screen, describe on next page</i>


Print Name of Responsible Licensee and License No. Garl Moseley Date 1-1-80 Signature of Licensee [Signature]

I HEREBY CERTIFY that the well/borehole was drilled, constructed, and completed in accordance with all applicable requirements of the Mississippi Department of Environmental Quality and the Mississippi Department of Health regulations, if applicable, and state laws.

Landowner Name: _____

Sketch the property layout and include the following:
 1) the well location
 2) any permanent structures on the property that may aid in locating the well
 3) any roads, power lines, or other items that may aid in locating the property and the well
 4) north arrow

If more than one screen, show location of each on sketch

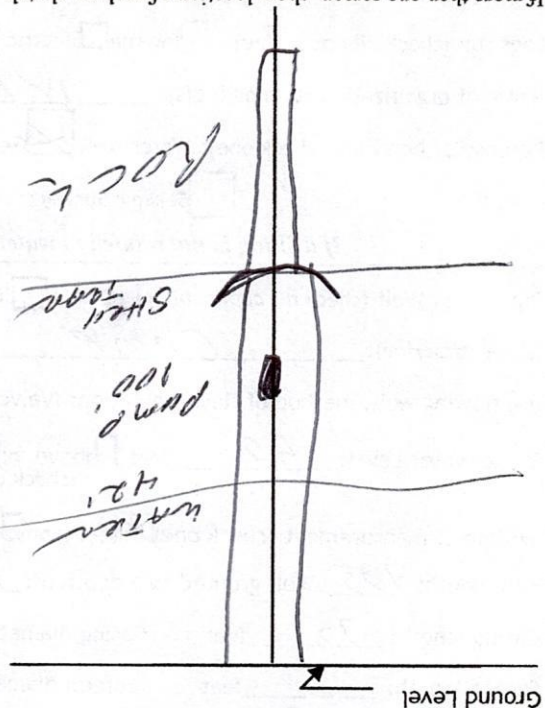

If well telescopes, show depths on sketch

The sketch below only required for water wells

County: Wayne Permit #: _____

Description of Formations Encountered	From (depth)	To (depth)
SAND	35	70
CLAY	70	72
ROCK	72	73
CLAY	73	74
ROCK	74	75
CLAY	75	76
ROCK	76	77
CLAY	77	78
ROCK	78	79
CLAY	79	80
ROCK	80	81
CLAY	81	82
ROCK	82	83
CLAY	83	84
ROCK	84	85
CLAY	85	86
ROCK	86	87
CLAY	87	88
ROCK	88	89
CLAY	89	90
ROCK	90	91
CLAY	91	92
ROCK	92	93
CLAY	93	94
ROCK	94	95

Description of formations encountered must be provided for all wells and boreholes, unless specifically exempted by regulations

Well #: _____ For Office Use Only:

STATE WELL REPORT

Part 2

Pump Installer's Completion Report
Mississippi Department of Environmental Quality
Office of Land and Water Resources
P.O. Box 2309
Jackson, MS 39225
(601)961-5210
(601)961-5228 (fax)

County: Wayne
Permit #: 5496
Driller: EARL MUSELEY
Date completed: 1-6-20
Copy information from block on Part 1

For Office Use Only:

Aquifer: _____
Well #: P 92
Elevation: _____

This part of the report must be completed by a licensed water well contractor or a licensed pump installer. A copy of Part 1 of the report must be attached and both parts filed with the Department at the above address within 30 days of well completion.

Well Owner Information

Owner Name: JASON COOLEY
Mailing Address: MARTIN SUNLIGHT RD
Waynesboro MS 39367
City State Zip Code
Telephone No. (601) ~~301~~ -310-2402

Well Location

Latitude: 31.679 Longitude: 88.503
Method of Lat/Long (check one): Conventional Survey _____
USGS quad _____, Hand-held GPS ☒, Survey-grade GPS _____
NE SW 1/4 NE 1/4 Sec 8 T 8N R 5W
Distance Direction Nearest Town
10 Miles EAST of Waynesboro

Pump Type

Circle one

Air Lift Jet Submersible
Bucket Piston Turbine
Centrifugal Rotary Flowing Well
Other (specify): _____
Date Pump Installed: 1-8-20
Rated Pump Capacity: 7 Gallons Per Minute

Power Type

Circle one

Diesel Engine Gasoline Engine Natural Gas
Electric Motor Hand Tractor PTO
Windmill Other (specify): _____
Horse Power Rating of Motor: 1/2
Setting Depth: 100 feet
Number of Stages: _____

Pump Test Data

Date Well Tested: 1-8-20
Static Water Level (A): 42 Feet Below Land Surface
Pumping Water Level (B): 100 Feet Below Land Surface
Drawdown [(B) - (A)]: 58 Feet Below Land Surface
Test Pumping Rate: 12 Gallons Per Minute
Duration of Pump Test (minimum 4 hours): 4 hours

Method of Measuring Water Level

Circle one

Air Line Electric Measuring Line Steel Tape
Other (specify): _____
For flowing well, measured shut in head: _____ feet
Well yielded _____ GPM with a drawdown of _____ feet after _____ hours of pumping

I HEREBY CERTIFY that the above statements are true to the best of my knowledge.

EARL MUSELEY 5496
Print Name of Pump Installer and License No. (if applicable)

Signature of Pump Installer


Form: OLWR-SWR-1B (04/08)

RECEIVED
FEB 06 2020
OLWR

WAYNE COUNTY, MISSISSIPPI

Scale 1:27,000
1 Inch = 2,250 US Survey Feet

Jason Cowley

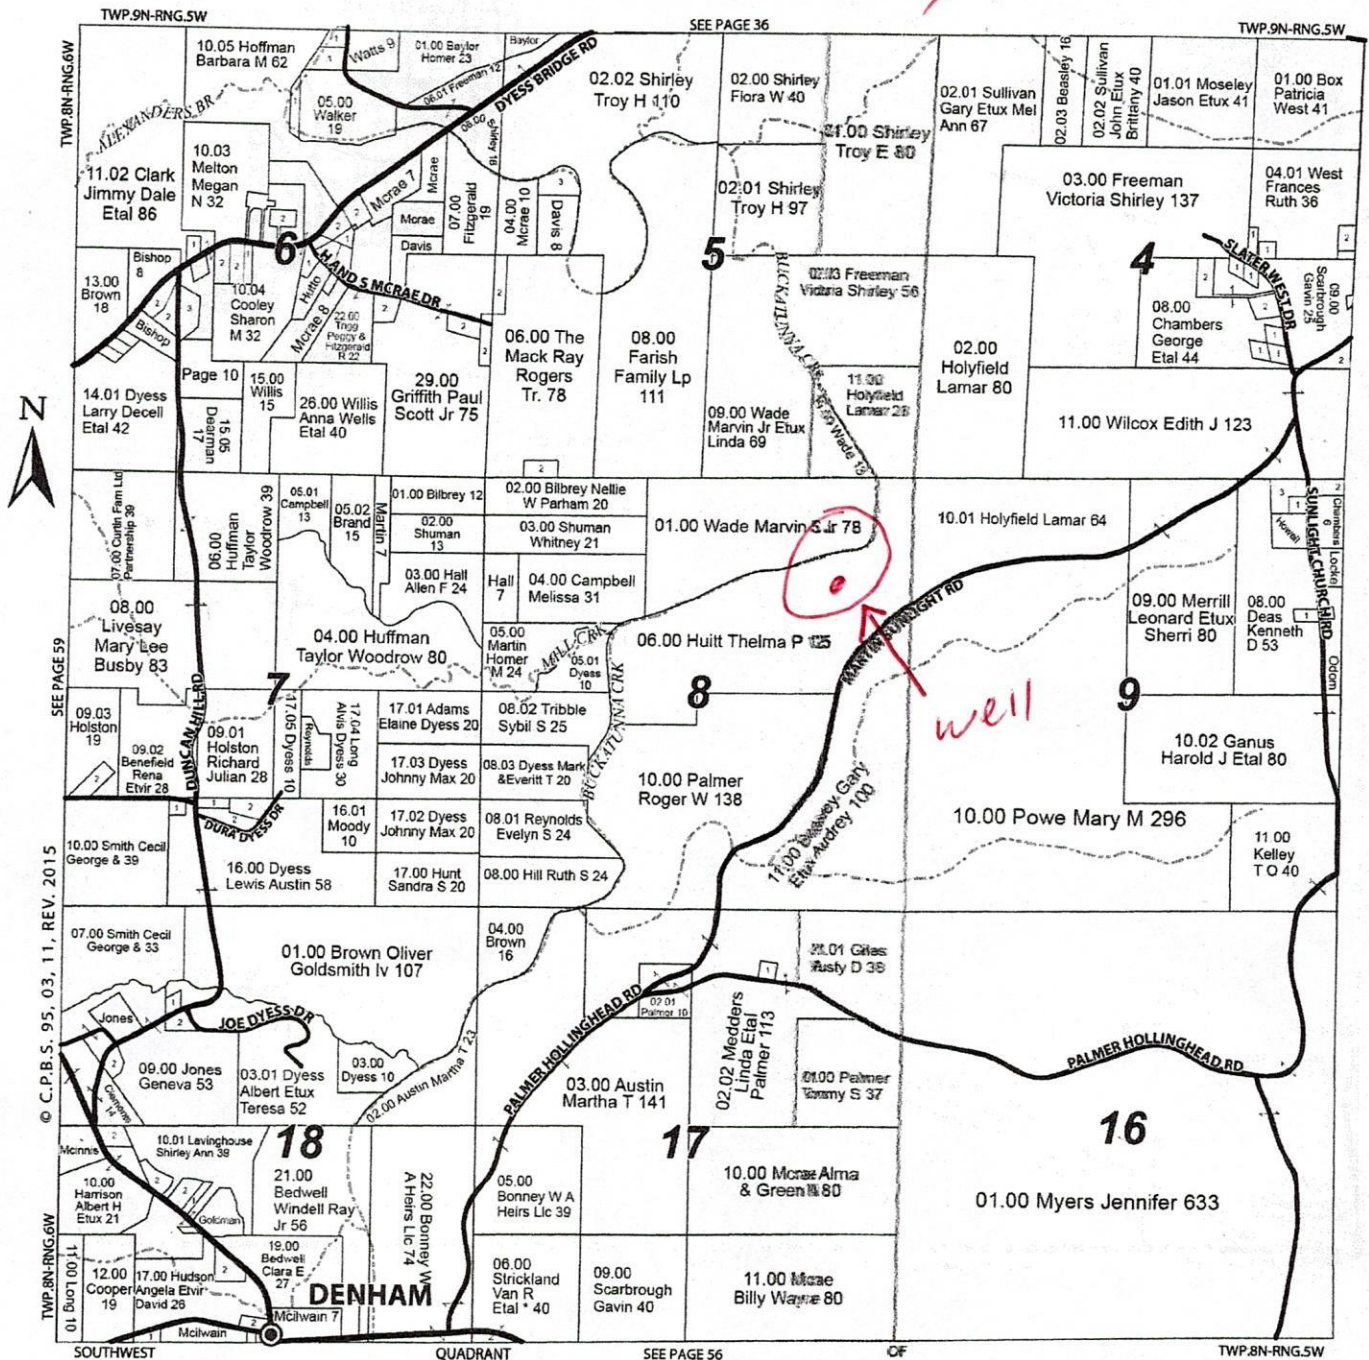

RECEIVED
FEB 06 2020
BY OLWR