

Wayne
 P 2000
 4-17-76

MISSISSIPPI
 BOARD OF WATER COMMISSIONERS
 416 North State Street
 Jackson, Mississippi 39201

WATER WELL DRILLERS LOG

April 17, 76 19 McILWAIN WATER WELL SERVICE Wayne
 date well completed RT firm name BOX 37 county well located

WAYNESBORO, MISS. 39367


LANDOWNER:
 LEROY LASSITER
 Rt 4 WAYNESBORO, Miss.
 (mailing address)

description of formations encountered	from	to
Red Clay	0	12
Red Sand	12	35
Sand + Clay streaks	35	92
Sand	92	97

WELL LOCATION:
 sec. 29 T 8 N R 5 E W'BO
 10 miles (distance) of (direction) (nearest town)

WELL PURPOSE: HOME
 (home, irrigation, municipal, industrial)

- WELL COMPLETION DATA:
- (1) diameter (inches) 2"
 - (2) total depth (feet) 97'
 - (3) static water level (feet) 83' below top of ground
 - (4) casing PVC 93'
 (material) (depth)
2"
 (size) If telescope see back.
 - (5) screen 4' 93'
 (length) (depth to top)
2" PVC .008
 (size) (material)
 - (6) pump 1 5
 (HP) (yield gpm)
110 AC
 (type power)
 - (7) electric log no
 (yes or no)
- (organization running log)
- (8) how well bottom plugged _____

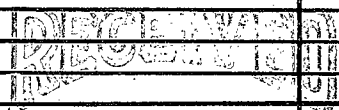


APR 20 1976

DRILLERS REMARKS:

If well telescopes please sketch and show depths.

GROUND LEVEL

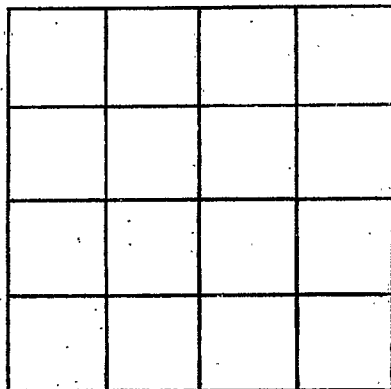

SECTION _____

Please indicate well location X.

ADDITIONAL INFORMATION

If more than one screen, show locations of each on sketch.