

Wayne
 P 2003
 8/1/76

MISSISSIPPI
 BOARD OF WATER COMMISSIONERS
 416 North State Street
 Jackson, Mississippi 39201

WATER WELL DRILLERS LOG

13P
 7/16
 date well completed
 RT. firm name BOX 37
 WAYNESBORO, MISS. 39367
 county well located Wayne

LANDOWNER:
 Paul Taylor
 Waynesboro Miss.
 (mailing address)

WELL LOCATION:
 sec. 27 T. 8 N. R. 5 E. W. 10
 10 miles E of W'boro
 (distance) (direction) (nearest town)

WELL PURPOSE: HOME
 (home, irrigation, municipal, industrial)

- WELL COMPLETION DATA:
- (1) diameter (inches) 2"
 - (2) total depth (feet) 105'
 - (3) static water level (feet) 65' below top of ground.
 - (4) casing PVC, 100' (material) (depth)
 2" (size) If telescope see back.
 - (5) screen 5', 100' (length) (depth to top)
 1/4" SSTEEL (size) (material)
 - (6) pump 1, 8 (HP) (yield gpm)
 220 AC (type power)
 - (7) electric log no (yes or no)
 - (8) how well bottom plugged

description of formations encountered	from	to
Red Clay	0	6
Red Sand	6	12
Clay & some sand	12	30
Clay	30	93
Rock	93	94
Sand	94	105


RECEIVED
 OCT - 5 1976

WATER

DRILLERS REMARKS:

If well telescopes please sketch and show depths.

GROUND LEVEL

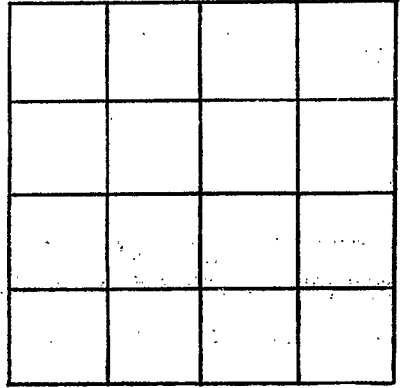

SECTION _____

Please indicate well location X.

ADDITIONAL INFORMATION

If more than one screen, show locations of each on sketch.