

WAYNE
 P 2005
 8/23/76

MISSISSIPPI
 BOARD OF WATER COMMISSIONERS
 416 North State Street
 Jackson, Mississippi 39201

WATER WELL DRILLERS LOG

Aug 23, 1976 date well completed
 McILWAIN WATER WELL SERVICE RT. # 37
 WAYNESBORO, MISS. 39367
 Wayne county well located


LANDOWNER:	description of formations encountered	from	to
Wayne West Waynesboro, Miss (mailing address)			
WELL LOCATION:	Sand	13	15
sec. 31 T. 8 N R. 5 E	Clay	15	35
9 miles SE of W'boro	Sand	35	89
(distance) (direction) (nearest town)			
WELL PURPOSE: HOME (home, irrigation, municipal, industrial)			
WELL COMPLETION DATA:			
(1) diameter (inches) 2"			
(2) total depth (feet) 89			
(3) static water level (feet) 55' below top of ground.			
(4) casing PVC 81' (material) (depth)			
2" If telescope see back. (size)			
(5) screen 8' 81' (length) (depth to top)			
2" PVC .008 (size) (material)			
(6) pump 1 10 (HP) (yield gpm)			
220 AC (type power)			
(7) electric log NO (yes or no)			
(organization running log)			
(8) how well bottom plugged			
DRILLERS REMARKS:			

RECEIVED
 OCT - 5 1976

MISS. BD. OF WATER COM.

If well telescopes please
sketch and show depths.

GROUND LEVEL

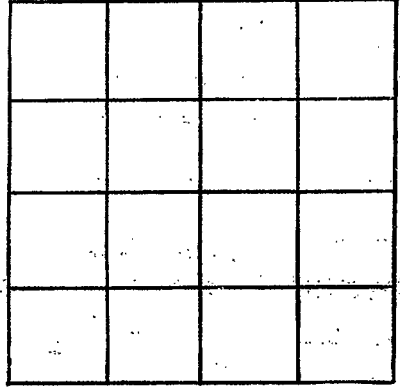

SECTION _____

Please indicate well location X.

ADDITIONAL INFORMATION

If more than one screen,
show locations of each on sketch.