

WAYNE
 P 5000
 12-21-76

MISSISSIPPI
 BOARD OF WATER COMMISSIONERS
 416 North State Street
 Jackson, Mississippi 39201

WATER WELL DRILLERS LOG

McILWAIN WATER WELL SERVICE Wayne

Dec. 21 1976
 date well completed

RT. 2 BOX 37
 firm name
 WAYNESBORO MISS 39267

county well located


LANDOWNER:	description of formations encountered	from	to
Mr. Joe Taylor Waynesboro, Miss. (mailing address)			
WELL LOCATION:	Clay	28	32
sec. 21 T 8 N R 5 E 10 miles E of Wboro (distance) (direction) (nearest town)	Sand	32	42
WELL PURPOSE: (home, irrigation, municipal, industrial)	Clay	42	70
WELL COMPLETION DATA:	Sand	70	78
(1) diameter (inches) 2"	Clay	78	85
(2) total depth (feet) 100'	Sand	85	100
(3) static water level (feet) 80' below top of ground.			
(4) casing PVC 95' 2" (material) (depth)			
4x2 If telescope see back. (size)			
(5) screen 5' 95' (length) (depth to top)			
2' PVC (size) (material)			
(6) pump 1 7 (HP) (yield gpm)			
110 AC (type power)			
(7) electric log No (yes or no)			
(organization running log)			
(8) how well bottom plugged			
DRILLERS REMARKS:			

RECEIVED
 JAN 21 1977

MISS. BD. OF WATER COMMISSIONERS

If well telescopes please sketch and show depths.

GROUND LEVEL

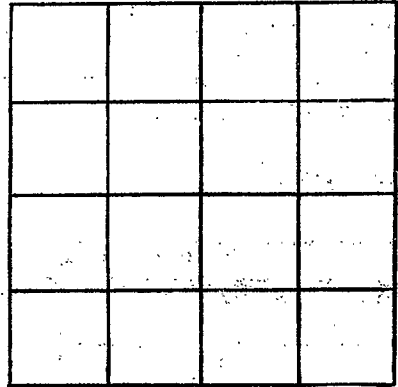

SECTION _____

Please indicate well location X.

ADDITIONAL INFORMATION

If more than one screen, show locations of each on sketch.