

WAYNE
P 2008
7-26-77

MISSISSIPPI
BOARD OF WATER COMMISSIONERS
416 North State Street
Jackson, Mississippi 39201

13P

WATER WELL DRILLERS LOG

McILWAIN WATER WELL SERVICE

July 26
date well completed

1977

RT. 2 BOX 22

Wayne

WAYNESBORO, MISS. 39362

county well located

LANDOWNER:	description of formations encountered	from	to
Horace Odom			
Waynesboro Miss (mailing address)	Sand	12	33
WELL LOCATION:	Clay	33	42
sec. <u>3</u> T. <u>8</u> N R. <u>5</u> E	Sand + Clay	42	85
<u>9</u> miles <u>E</u> of <u>Waynesboro</u>	Sand	85	99
(distance) (direction) (nearest town)			
WELL PURPOSE: <u>Home</u> (home, irrigation, municipal, industrial)			
WELL COMPLETION DATA:			
(1) diameter (inches) <u>2"</u>			
(2) total depth (feet) <u>99'</u>			
(3) static water level (feet) <u>80'</u> <small>below above</small> top of ground.			
(4) casing <u>PVC</u> <u>94'</u> (material) (depth)			
<u>2"</u> (size) If telescope see back.			
(5) screen <u>5'</u> <u>94'</u> (length) (depth to top)			
<u>2"</u> <u>PVC .008</u> (size) (material)			
(6) pump <u>1</u> <u>5</u> (HP) (yield gpm)			
<u>110 AC</u> (type power)			
(7) electric log <u>No</u> (yes or no)			
<u></u> (organization running log)			
(8) how well bottom plugged <u></u>			
DRILLERS REMARKS:			


RECEIVED

SEP 10 1977

MISS. RD. OF WATER

If well telescopes please sketch and show depths.

GROUND LEVEL

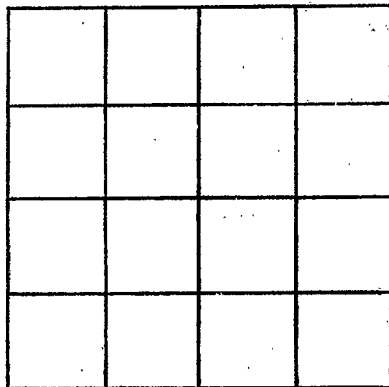

SECTION _____

Please indicate well location X.

ADDITIONAL INFORMATION

If more than one screen,
show locations of each on sketch.