

Wayne
P. 2007
5-11-77

MISSISSIPPI
BOARD OF WATER COMMISSIONERS
416 North State Street
Jackson, Mississippi 39201

WATER WELL DRILLERS LOG

4 May 11 1977 date well completed
RT. 2, BOX 37
Waynesboro, Miss. 39367
Wayne county well located

LANDOWNER:
Mrs. A. W. Palmer
Waynesboro Miss.
(mailing address)

description of formations encountered	from	to
Red Clay	0	5
Red Sand	5	14
Clay	14	28
Sand	28	30

WELL LOCATION:
sec. 17 T. 8 N. R. 15 E.
7 miles @ E of Wilboro
(distance) (direction) (nearest town)

WELL PURPOSE: Home
(home, irrigation, municipal, industrial)

- WELL COMPLETION DATA:
- (1) diameter (inches) 2 1/2"
 - (2) total depth (feet) 30'
 - (3) static water level (feet) 20' below top of ground.
 - (4) casing PVC 25' (material) (depth)
2" (size) if telescope see back.
 - (5) screen 5' 25' (length) (depth to top)
2" PVC .008 (size) (material)
 - (6) pump 1/2 7 (HP) (yield gpm)
110 AC (type power)
 - (7) electric log No (yes or no)
 - (8) how well bottom plugged


DRILLERS REMARKS:

RECEIVED
MAY 21 1977

MISS. BD. OF WATER COMMISSIONERS

If well telescopes please
sketch and show depths.

GROUND LEVEL

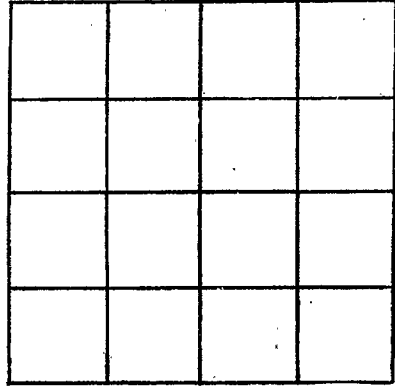

SECTION _____

Please indicate well location X.

ADDITIONAL INFORMATION

If more than one screen,
show locations of each on sketch.