

WAYNE

P 2010

12-28-77

MISSISSIPPI BOARD OF WATER COMMISSIONERS  
416 North State Street  
Jackson, Mississippi 39201

WATER WELL DRILLERS LOG

Dec 28  
date well completed

McILWAIN WATER WELL SERVICE

Wayne  
county well located

RT. 2, BOX 37

WAYNESBORO, MISS. 39367

LANDOWNER:

Olin Rannels  
Waynesboro, Miss  
(mailing address)

description of formations encountered

from to

Sand	0	5
Clay	5	38
Sand Rock	38	39
Sand & Clay	39	45
Sand	45	59

WELL LOCATION:

sec. 27 T. 8 N R. 5 E  
12 miles SE of W'boro  
(distance) (direction) (nearest town)

WELL PURPOSE: Home  
(home, irrigation, municipal, industrial)

WELL COMPLETION DATA:

- (1) diameter (inches) 2"
- (2) total depth (feet) 59'
- (3) static water level (feet) 33' below top of ground.
- (4) casing PVC 54' (material) (depth)  
2" (size) if telescope see back.
- (5) screen 5' 54' (length) (depth to top)  
2" PVC .008 (size) (material)
- (6) pump 1 12 (HP) (yield gpm)  
220 AC (type power)
- (7) electric log No (yes or no)  
(organization running log)
- (8) how well bottom plugged


DRILLERS REMARKS:

RECEIVED  
APR 24 1978

BOARD OF WATER COMMISSIONERS

If well telescopes please  
sketch and show depths.

GROUND LEVEL

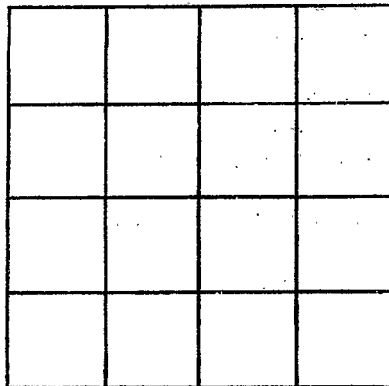

SECTION \_\_\_\_\_

Please indicate well location X.

ADDITIONAL INFORMATION

If more than one screen,  
show locations of each on sketch.