

WAYNE  
 P. 5000  
 5-25-78

MISSISSIPPI  
 BOARD OF WATER COMMISSIONERS  
 416 North State Street  
 Jackson, Mississippi 39201

WATER WELL DRILLERS LOG  
 McILWAIN WATER WELL SERVICE

May 25 1978  
 date well completed

RT. 2, BOX 37

WAYNESBORO, MISS. 39367

Wayne  
 county well located


LANDOWNER:	description of formations encountered	from	to
Woodrow Hollingshead Waynesboro Ms. (mailing address)			
	Red Sand	8	12
WELL LOCATION:	Clay	12	32
sec. 11 T. 8 N. R. 5 E. S. 1	SAND + CLAY	32	40
12 miles E of W'boro (distance) (direction) (nearest town)	Coarse SAND	40	63
WELL PURPOSE: Home - Farm (home, irrigation, municipal, industrial)			
WELL COMPLETION DATA:			
(1) diameter (inches) 2"			
(2) total depth (feet) 63'			
(3) static water level (feet) 32' below above top of ground.			
(4) casing PVC 57' (material) (depth) 2" if telescope see back. (size)			
(5) screen 5' 58' (length) (depth to top) 2" PVC .008 (size) (material)			
(6) pump 1 11 (HP) (yield gpm) 220 AC (type power)			
(7) electric log No (yes or no)			
(organization running log)			
(8) how well bottom plugged			
DRILLERS REMARKS:			

RECEIVED  
 JUN 12 1978

MISS. BO. OF WATER COMMISSIONERS

If well telescopes please  
sketch and show depths.

GROUND LEVEL

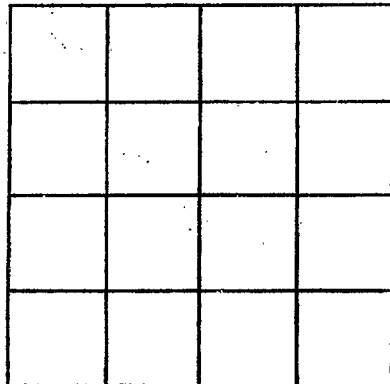

SECTION \_\_\_\_\_

Please indicate well location X.

ADDITIONAL INFORMATION

If more than one screen,  
show locations of each on sketch.