

WAYNE  
 P 3012  
 7-30-78

MISSISSIPPI  
 BOARD OF WATER COMMISSIONERS  
 416 North State Street  
 Jackson, Mississippi 39201

WATER WELL DRILLERS LOG  
 WILCOWAIN WATER WELL SERVICE

WAYNE

July 30 1978  
 date well completed

RT 2 BOX 37  
 WAYNESBORO, MISS. 39367

county well located

LANDOWNER:  
 Morgan Taylor  
 Waynesboro Ms.  
 (mailing address)

description of formations encountered	from	to
Red Sand	0	21
Clay	21	63
Five Sand + Clay	63	78
Med Sand + Clay	78	98
Sand	98	109

WELL LOCATION:  
 sec. 22 T. 8 N R. 5 W.  
 13 miles SE of W. Boro  
 (distance) (direction) (nearest town)

WELL PURPOSE: Home  
 (home, irrigation, municipal, industrial)

WELL COMPLETION DATA:

(1) diameter (inches) 2"

(2) total depth (feet) 109'

(3) static water level (feet) 65' below above top of ground.

(4) casing PVC 104' (material) (depth)  
 2" (size) if telescope see back.

(5) screen 5' 104' (length) (depth to top)  
 2" (size) PVC 008 (material)

(6) pump 1 (HP) 9 (yield gpm)  
 220 AC (type power)

(7) electric log No (yes or no)

(organization running log)

(8) how well bottom plugged

DRILLERS REMARKS:


RECEIVED

AUG 11 1978

MISS. BD. OF WATER COMMISSIONERS

If well telescopes please sketch and show depths.

GROUND LEVEL

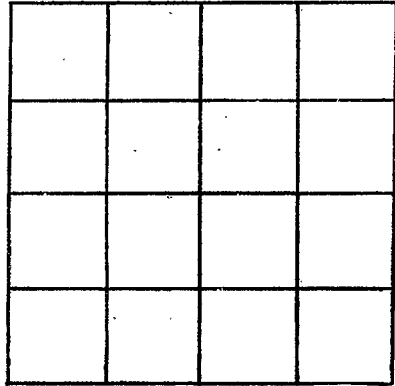

SECTION \_\_\_\_\_

Please indicate well location X.

ADDITIONAL INFORMATION

If more than one screen,  
show locations of each on sketch.