

WAYNE

P  
2044

10-11-78

MISSISSIPPI  
BOARD OF WATER COMMISSION

416 North State Street  
Jackson, Mississippi 39201

MISSISSIPPI  
MOTOR WATER WELL DRILLERS LOG

RT. 2, BOX 37

WAYNESBORO, MISS. 39267

Wayne

Oct. 11 1978  
date well completed

firm name

county well located

LANDOWNER:	description of formations encountered	from	to
Selvin West Waynesboro, MS. (mailing address)			
WELL LOCATION: sec. <u>32</u> T. <u>8</u> N. R. <u>5</u> <u>11</u> miles <u>SE</u> of <u>W'boro</u> (distance) (direction) (nearest town)	Red SAND	12	28
WELL PURPOSE: <u>home</u> (home, irrigation, municipal, industrial)	CLAY	28	75
WELL COMPLETION DATA: (1) diameter (inches) <u>2"</u>	Fine SAND	75	80
(2) total depth (feet) <u>91'</u>	Med. SAND	80	91
(3) static water level (feet) <u>68'</u> below top of ground.			
(4) casing <u>PVC</u> , <u>81'</u> (material) (depth) <u>2"</u> if telescope see back. (size)			
(5) screen <u>10"</u> , <u>81'</u> (length) (depth to top) <u>2"</u> , <u>PVC</u> , <u>608</u> (size) (material)			
(6) pump <u>1</u> <u>8</u> (HP) (yield gpm) <u>220 AC</u> (type power)			
(7) electric log: <u>NO</u> (yes or no) (organization running log)			
(8) how well bottom plugged			
DRILLERS REMARKS:			


RECEIVED  
JAN 2 1978

MISS. BD. OF WATER COMMISSION

depths.

McILWAIN

GROUND LEVEL

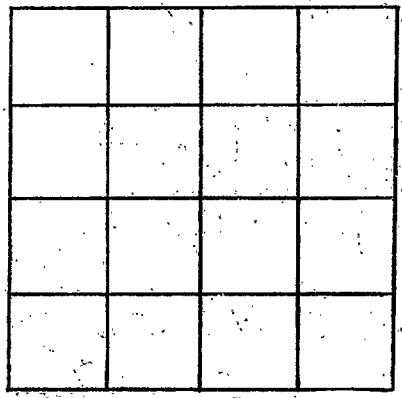

SECTION \_\_\_\_\_

Please indicate well location X.

ADDITIONAL INFORMATION

A series of horizontal lines for providing additional information, starting below the 'ADDITIONAL INFORMATION' header and extending to the bottom of the page.

If more than one screen, show locations of each on sketch.