

Wayne
P 2015
5-16-79

MISSISSIPPI
BOARD OF WATER COMMISSIONERS
416 North State Street
Jackson, Mississippi 39201

WATER WELL DRILLERS LOG
McILWAIN WATER WELL SERVICE

Wayne

5-16 19 79
date well completed

RT 2, BOX 37

WAYNESBORO, MISS. 39367

county well located


LANDOWNER:	description of formations encountered	from	to
Lamar Ramsey, Jr. Waynesboro, Ms. (mailing address)			
WELL LOCATION: sec. 10 T 8 N R 5 E 13 miles E of W'boro (distance) (direction) (nearest town)	BROWN CLAY	4	8
WELL PURPOSE: Home (home, irrigation, municipal, industrial)	SAND & CLAY	8	14
WELL COMPLETION DATA: (1) diameter (inches) 2" (2) total depth (feet) 95' (3) static water level (feet) 65' below top of ground. (4) casing PVC 90' (material) (depth) 2" (size) If telescope see back. (5) screen 5' 90' (length) (depth to top) 2" PVC .008 (size) (material) (6) pump 1 8 (HP) (yield gpm) 220 AC (type power) (7) electric log NO (yes or no) (organization running log) (8) how well bottom plugged	CLAY	14	18
	SAND ROCKS	18	20
	CLAY	20	52
	Red SAND	52	53
	Red clay +		
	SAND ROCKS	53	55
	Red SAND	55	57
	White CLAY	57	60
	Fine SAND	60	68
DRILLERS REMARKS:	SAND Med COARSE	68	85
	COARSE SAND	85	95

JUN 14 1979

Miss. Board of Water Comm.

If well telescopes please sketch and show depths.

GROUND LEVEL

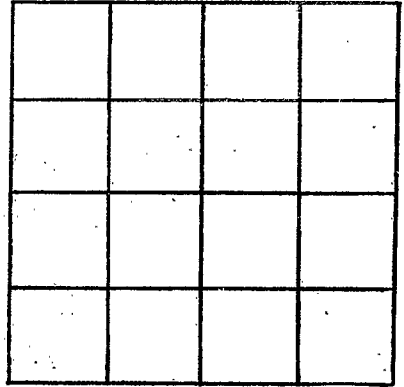

SECTION _____

Please indicate well location X.

ADDITIONAL INFORMATION

If more than one screen,
show locations of each on sketch.