

Wayne  
P 2214  
8-1-79

MISSISSIPPI  
 BOARD OF WATER COMMISSIONERS  
 416 North State Street  
 Jackson, Mississippi 39201

WATER WELL DRILLERS LOG


Aug 1 19 79 Porter Drilling Itazone  
 date well completed firm name county well located

LANDOWNER:	description of formations encountered	from	to
<u>Deane Lewis</u>			
<u>Box 1 Buckatanna</u>	<u>Clay</u>	<u>0</u>	<u>8</u>
<u>Miss.</u>	<u>sand</u>	<u>8</u>	<u>24</u>
(mailing address)	<u>Clay</u>	<u>24</u>	<u>34</u>
WELL LOCATION:	<u>sand</u>	<u>34</u>	<u>58</u>
sec. <u>9</u> T. <u>80</u> N. R. <u>5</u> E. <u>W</u>	<u>sand &amp; clay</u>	<u>58</u>	<u>89</u>
<u>9</u> miles <u>E</u> of <u>Haynesboro</u>	<u>from sand</u>	<u>89</u>	<u>96</u>
(distance) (direction) (nearest town)	<u>soft sand. clay</u>	<u>96</u>	<u>104</u>
WELL PURPOSE: <u>Home</u>	<u>from sand</u>	<u>104</u>	<u>112</u>
(home, irrigation, municipal, industrial)	<u>stratum soft sand</u>		
	<u>or clay</u>		
WELL COMPLETION DATA:			
(1) diameter (inches) <u>2"</u>	<u>71' 1" P.V.C. drop</u>		
(2) total depth (feet) <u>112'</u>	<u>pipe</u>		
(3) static water level (feet) <u>56</u> (below/above top of ground)			
(4) casing <u>P.V.C.</u> <u>107'</u> (material) (depth)			
<u>2"</u> (size) if telescope see back.			
(5) screen <u>5'</u> <u>107</u> (length) (depth to top)			
<u>2"</u> <u>2 slot P.V.C.</u> (size) (material)			
(6) pump <u>1</u> <u>8</u> (HP) (yield gpm)			
<u>elec</u> (type power)			
(7) electric log <u>no</u> (yes or no)			
(organization running log)			
(8) how well bottom plugged <u>2" sand shock</u>			
DRILLERS REMARKS:			
<u>steel logs</u>			

Miss. Board of Water Comm.  
 SEP 10 1979  
 RECEIVED

If well telescopes please sketch and show depths.

GROUND LEVEL

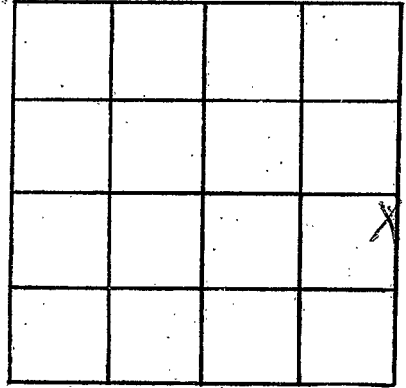

SECTION 9

Please indicate well location X.

ADDITIONAL INFORMATION

If more than one screen,  
show locations of each on sketch.