

Wayne
P207
7-16-79

MISSISSIPPI
 BOARD OF WATER COMMISSIONERS
 416 North State Street
 Jackson, Mississippi 39201

WATER WELL DRILLERS LOG

July 16 1979 Porter Drilling 24 anyre
 date well completed firm name county well located

LANDOWNER Larry Smith

At 1 Buchatunga, Miss

(mailing address)

WELL LOCATION:

sec. 32 T. 2 N. R. 5 E.
5 miles N of Buchatunga
 (distance) (direction) (nearest town)

WELL PURPOSE:

Home
 (home, irrigation, municipal, industrial)

WELL COMPLETION DATA:

- (1) diameter (inches) 2"
- (2) total depth (feet) 70'
- (3) static water level (feet) 54' (below above top of ground)
- (4) casing PVC 65'
(material) (depth)
2"
(size) if telescope see back.
- (5) screen 5' 65'
(length) (depth to top)
2" 60 lb SS
(size) (material)
- (6) pump 1 4
(HP) (yield gpm)
elec
(type power)
- (7) electric log no
(yes or no)
(organization running log)

(8) how well bottom plugged 2 sand shank

DRILLERS REMARKS:

shell top

description of formations encountered	from	to
clay	0	10
sand & clay	10	16
rock	16	24
sand	24	55
sand & clay	55	58
clay & sand	58	64
med salt	64	70
sand & clay	70	78
stop on rock		

62' 1" P.V.C drop pipe


Miss. Board of Water Comm.

SEP 10 1979

RECEIVED

If well telescopes please sketch and show depths.

GROUND LEVEL

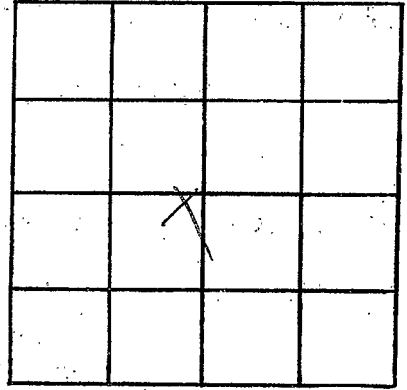

SECTION 32

Please indicate well location X.

ADDITIONAL INFORMATION

If more than one screen,
show locations of each on sketch.