

WAYNE  
P 2018  
1/10/80

MISSISSIPPI  
BOARD OF WATER COMMISSIONERS  
416 North State Street  
Jackson, Mississippi 39201

WATER WELL DRILLERS LOG

Jan 10 1980 date well completed  
Porter Drilling & Log. Wayne firm name  
Wayne county well located

| LANDOWNER: <u>Jefferson</u>   | description of formations encountered | from | to |
|---|---------------------------------------|------|----|
| <u>Donkins Jr.</u><br><u>William B. Mills Court.</u><br><u>P.O. Box 51</u> (mailing address)  | sand & clay                           | 0    | 36 |
| WELL LOCATION:<br>sec. <u>10</u> T <u>2</u> N R <u>5</u> E<br><u>9</u> miles <u>east</u> of <u>Winnfield</u><br>(distance) (direction) (nearest town) | clay                                  | 36   | 60 |
| WELL PURPOSE: <u>home</u><br>(home, irrigation, municipal, industrial)  | med. sand                             | 60   | 68 |
| WELL COMPLETION DATA:   | sand some clay                        | 68   | 73 |
| (1) diameter (inches) <u>8"</u>   | med sand                              | 73   | 75 |
| (2) total depth (feet) <u>85'</u>   | shrub drilling<br>w/ble still in hand |      |    |
| (3) static water level (feet) <u>66</u> <u>below</u><br>top of ground: <u>above</u>   |                                       |      |    |
| (4) casing <u>PVC</u> , <u>80'</u><br>(material) (depth)<br><u>2"</u><br>(size) If telescope see back.  |                                       |      |    |
| (5) screen <u>5'</u> , <u>80'</u><br>(length) (depth to top)<br><u>2"</u> , <u>80' sch. P.V.C.</u><br>(size) (material)                               |                                       |      |    |
| (6) pump <u>1</u> , <u>8</u><br>(HP) (yield gpm)<br><u>elec</u><br>(type power)   |                                       |      |    |
| (7) electric log <u>no</u><br>(yes or no)   |                                       |      |    |
| (organization running log)  |                                       |      |    |
| (8) how well bottom plugged<br><u>2" sand slush</u>   |                                       |      |    |
| DRILLERS REMARKS:<br><u>shut top above screen</u><br><u>7.8' 1" P.V.C. drop pipe</u>  |                                       |      |    |


DEPT. OF NATURAL RESOURCES  
BUREAU OF LAND & WATER RESOURCES

MAR 18 1980

RECEIVED

If well telescopes please sketch and show depths.

GROUND LEVEL

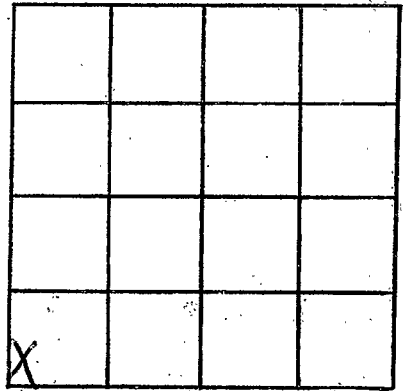

SECTION 10

Please indicate well location X.

ADDITIONAL INFORMATION

If more than one screen,  
show locations of each on sketch.