

MISSISSIPPI DEPARTMENT OF NATURAL RESOURCES

Bureau of Land and Water Resources

Southport Mall

P.O. Box 10631

Jackson, Mississippi 39209

WATER WELL DRILLERS LOG

WAYNE
P 209
7-30-80

July 30 1980 *Booster Drilling & Log* 2 of 2
 date well completed firm name county well located

LANDOWNER: *E. H. Kuffman* description of formations encountered from to
At 2
Haynesboro Miss. sand thin rock 0 42
 (mailing address) blue clay 42 45

WELL LOCATION:
 sec. 7-8 (N) R. 5 (E)
6 miles East Haynesboro
 (distance) (direction) (nearest town)

WELL PURPOSE: home
 (home, irrigation, municipal, industrial)

- WELL COMPLETION DATA:
- (1) diameter (inches) 2"
 - (2) total depth (feet) 35'
 - (3) static water level (feet) 20 below above top of ground.
 - (4) casing steel, 27'
 (material) (depth)
2' if telescope see back.
 (size)
 - (5) screen 5', 27'
 (length) (depth to top)
2", galot S.S.
 (size) (material)
 - (6) pump windmill 6
 (HP) (yield gpm)
wind
 (type power)
 - (7) electric log no
 (yes or no)
 (organization running log)
 - (8) how well bottom plugged
2' sand slack


DRILLERS REMARKS:

description of formations encountered	from	to
sand	0	42
thin rock		42
blue clay	42	45
2' brass working barrel - above screen		
bottom part of sand water but produce		

DEPT. OF NATURAL RESOURCES
 BUREAU OF LAND & WATER RESOURCES
 SEP 24 1980
RECEIVED

If well telescopes please
sketch and show depths.

GROUND LEVEL

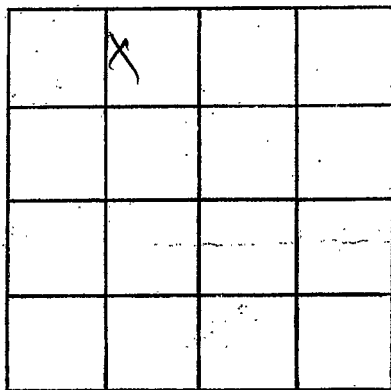

SECTION 7

Please indicate well location X.

ADDITIONAL INFORMATION

If more than one screen,
show locations of each on sketch.