

MISSISSIPPI DEPARTMENT OF NATURAL RESOURCES

Bureau of Land and Water Resources

Southport Mall

P.O. Box 10631

Jackson, Mississippi 39209

WATER WELL DRILLERS LOG

WAYNE
P 2000
2/16/81
Feb 16 1981
 date well completed

Boyer Drilling Shop firm name
Wayne county well located

LANDOWNER: Bertrude Mc Colister
At 2 Waynesboro Miss
 (mailing address)

description of formations encountered	from	to
clay	0	1.5
sand	1.5	2.2
clay	2.2	4.1
rock & strata	4.1	6.4
clay	6.4	11.8
Trachypora rock	11.8	14.5

WELL LOCATION:
 sec. 6 T. 8 N. R. 5 E.
7 miles E of Waynesboro
 (distance) (direction) (nearest town)

10.5' 1 1/4" galv. drop pipe

WELL PURPOSE: dom
 (home, irrigation, municipal, industrial)

WELL COMPLETION DATA:
 (1) diameter (inches) 2"
 (2) total depth (feet) 14.5'
 (3) static water level (feet) 82 below top of ground.
 (4) casing steel 119'
 (material) (depth)
2" if telescope see back.
 (size)
 (5) screen none used
 (length) (depth to top)
 (size) (material)
 (6) pump 1 1/2 10
 (HP) (yield gpm)
elec
 (type power)
 (7) electric log no
 (yes or no)
 (organization running log)

(8) how well bottom plugged open

DRILLERS REMARKS:


DEPT. OF NATURAL RESOURCES
 BUREAU OF LAND & WATER RESOURCES

MAR 6 1981

RECEIVED

If well telescopes please sketch and show depths.

GROUND LEVEL

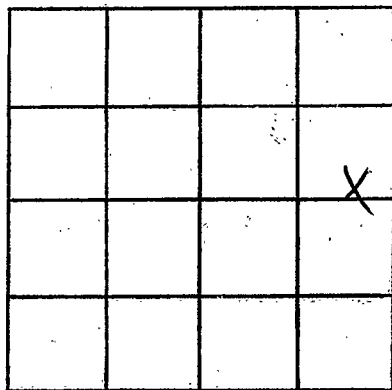

SECTION 6

Please indicate well location X.

ADDITIONAL INFORMATION

If more than one screen,
show locations of each on sketch.