

MISSISSIPPI DEPARTMENT OF NATURAL RESOURCES

Bureau of Land and Water Resources

Southport Mall

P.O. Box 10631

Jackson, Mississippi 39209

WATER WELL DRILLERS LOG

WALLEN
P. 0001
2/19/81
Feb 19

date well completed 19 81 Portland drilling & log firm name Itayne county well located

LANDOWNER: Arthene
Everette AS-1

description of formations encountered	from	to
clay	0	32
clay & sand	32	40
sand & clay	40	54
clay	54	57
soft sand	57	64
firm med sand	64	70
hard sand	70	85
firm med coarse sand	85	101
refine sand	101	106

Box 266A Buckatunga, Ms.
(mailing address)

WELL LOCATION:
sec. 9 T. 8 N. R. 5 E.
9 miles E. of Waynesboro
(distance) (direction) (nearest town)

WELL PURPOSE: Home
(home, irrigation, municipal, industrial)

WELL COMPLETION DATA:
(1) diameter (inches) 2"
(2) total depth (feet) 101'
(3) static water level (feet) 70 below top of ground.
(4) casing P.V.C. 96'
(material) (depth)
2" If telescope see back.
(size)
(5) screen 5' 96'
(length) (depth to top)
2" galv. S.S.
(size) (material)
(6) pump 1 8
(HP) (yield gpm)
elec.
(type power)
(7) electric log no
(yes or no)
(organization running log)

82' 1" PVC log pipe

(8) how well bottom plugged
2' backwash valve

DRILLERS REMARKS:


MISSISSIPPI DEPARTMENT OF NATURAL RESOURCES
BUREAU OF LAND & WATER RESOURCES

MAR - 6 1981

RECEIVED

If well telescopes please sketch and show depths.

GROUND LEVEL

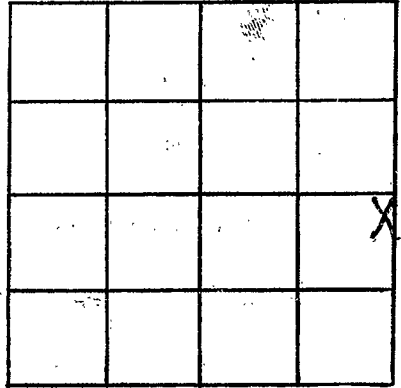

SECTION 9

Please indicate well location X.

ADDITIONAL INFORMATION

If more than one screen,
show locations of each on sketch.