

MISSISSIPPI DEPARTMENT OF NATURAL RESOURCES

Bureau of Land and Water Resources

Southport Mall

P.O. Box 10631

Jackson, Mississippi 39209

WATER WELL DRILLERS LOG

Wayne
P 2022
11-5-81

Nov 5 1981 date well completed
81 Gator Drilling & Log firm name
Wayne county well located

LANDOWNER: <u>David Entekken</u>	description of formations encountered	from	to
<u>Rt 1 Buckatunna Miss.</u> (mailing address)	<u>sandy clay</u>	<u>0</u>	<u>8</u>
WELL LOCATION: sec <u>33</u> T <u>8</u> N R <u>5</u> E <u>5</u> miles <u>NE</u> <u>Buckatunna</u> (distance) (direction) (nearest town)	<u>clay</u>	<u>8</u>	<u>53</u>
WELL PURPOSE: <u>some</u> (home, irrigation, municipal, industrial)	<u>well grey sand</u>	<u>53</u>	<u>60</u>
WELL COMPLETION DATA:	<u>loose coarse sand</u>	<u>60</u>	<u>65</u>
(1) diameter (inches) <u>2"</u>	<u>stippled white steel</u>		
(2) total depth (feet) <u>63'</u>	<u>in sand</u>		
(3) static water level (feet) <u>40</u> <u>below</u> above top of ground.	<u>52' 1" P.V.C. clay pipe</u>		
(4) casing <u>P.V.C.</u> <u>58'</u> (material) (depth)			
<u>2"</u> if telescope see back. (size)			
(5) screen <u>5'</u> <u>58'</u> (length) (depth to top)			
<u>2"</u> <u>half SS.</u> (size) (material)			
(6) pump <u>1</u> <u>10</u> (HP) (yield gpm)			
<u>elec.</u> (type power)			
(7) electric log <u>no</u> (yes or no)			
(organization running log)			
(8) how well bottom plugged <u>2" cement plug & steel trap</u>			
DRILLERS REMARKS:			


DEPT. OF NATURAL RESOURCES
BUREAU OF LAND & WATER RESOURCES

NOV 25 1981

RECEIVED

If well telescopes please sketch and show depths.

GROUND LEVEL

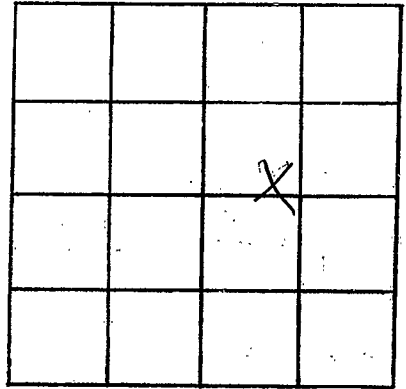

SECTION 33

Please indicate well location X.

ADDITIONAL INFORMATION

If more than one screen, show locations of each on sketch.