

P
2023

MISSISSIPPI
BOARD OF WATER COMMISSIONERS
416 North State Street
Jackson, Mississippi 39201

WATER WELL DRILLERS LOG

19 CHARRS Well Serv WALNOLA
date well completed firm name county well located

LANDOWNER: James BURTON
RT 1 BUCKATUNNA MS
39322
(mailing address)

WELL LOCATION:
sec 26 T 8 N R 5 E
2 1/2 miles NNE of PROGRESS
(distance) (direction) (nearest town)

WELL PURPOSE: Home
(home, irrigation, municipal, industrial)

- WELL COMPLETION DATA:
- (1) diameter (inches) 2
 - (2) total depth (feet) 110
 - (3) static water level (feet) 82 ^{below}/_{above} top of ground.
 - (4) casing PVC, 105
(material) (depth)
(size) if telescope see back.
 - (5) screen 2' x 5', 105
(length) (depth to top)
2", PVC WRAPPED
(size) (material)
 - (6) pump 1 6
(HP) (yield gpm)
Elect
(type power)
 - (7) electric log NO
(yes or no)
(organization running log)
 - (8) how well bottom plugged 2" PVC
CAP


description of formations encountered	from	to
Top Soil	0	1
Red SAND & CLAY	1	6
Red SAND	6	14
White CLAY	14	30
Red white SAND	30	42
White CLAY	42	76
Fine Redish SAND	76	83
COARSE yellow SAND	83	86
Red white SAND	86	98
Red yellow SAND	98	104
Red white SAND	104	110
Still in same when BIT		

DRILLERS REMARKS:

MISS. DEPT. OF NATURAL RESOURCES
BUREAU OF LAND & WATER RESOURCES
JAN 18 1982
RECEIVED

If well telescopes please sketch and show depths.

GROUND LEVEL

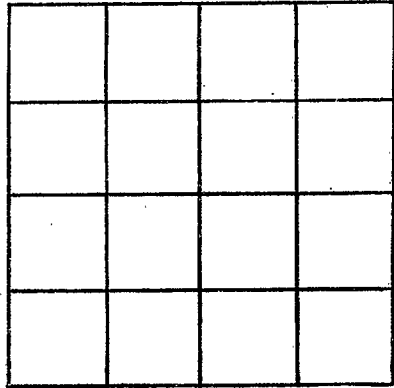

SECTION _____

Please indicate well location X.

ADDITIONAL INFORMATION

If more than one screen, show locations of each on sketch.