

MISSISSIPPI DEPARTMENT OF NATURAL RESOURCES

Bureau of Land and Water Resources

Southport Mall

P.O. Box 10631

Jackson, Mississippi 39209

WATER WELL DRILLERS LOG

Wayne  
P  
2087

Aug 20 1982

Porter Drilling Co

Wayne

date well completed

firm name

county well located

LANDOWNER:

Larry Lee

description of formations encountered

from

to

Plot 1  
Buckatunna Miss  
(mailing address)

Clay 0 19  
sand 19 37  
Clay 37 57  
sand 57 60  
Clay 60 69  
med. coarse sand 69 72  
shaly white shell  
in sand

WELL LOCATION:

sec. 27 80 N R 5 E  
10 miles SE of Jaynesboro  
(distance) (direction) (nearest town)

WELL PURPOSE: home  
(home, irrigation, municipal, industrial)

WELL COMPLETION DATA:

- (1) diameter (inches) 2"
- (2) total depth (feet) 78
- (3) static water level (feet) 12 (below above top of ground)
- (4) casing PVC 73' (material) (depth)  
2" (size) If telescope see back.
- (5) screen 5' 73' (length) (depth to top)  
2" salt PVC (size) (material)
- (6) pump 1 15 (HP) (yield gpm)  
elec. (type power)
- (7) electric log no (yes or no)

20' 1" P.V.C. down pipe  
shell top above screen

(organization running log)

(8) how well bottom plugged  
2" sand slush

DRILLERS REMARKS:


DEPT. OF NATURAL RESOURCES  
BUREAU OF LAND & WATER RESOURCES

SEP - 1 1982

RECEIVED

If well telescopes please sketch and show depths.

GROUND LEVEL

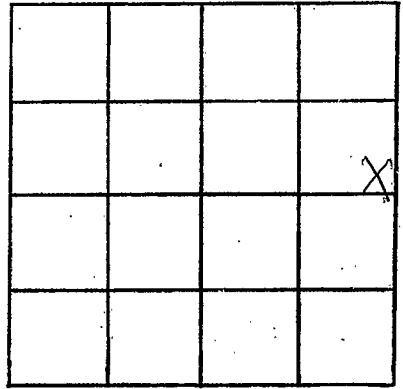

SECTION 27

Please indicate well location X.

ADDITIONAL INFORMATION

If more than one screen,  
show locations of each on sketch.