

Wayne  
P  
2028

MISSISSIPPI  
BOARD OF WATER COMMISSIONERS  
416 North State Street  
Jackson, Mississippi 39201

WATER WELL DRILLERS LOG

6-1 1983 PARRS Well Serv WAYNE  
date well completed firm name county well located


LANDOWNER: JAMES L. STACEY	description of formations encountered	from	to
R+I BUCKATUNNA	TOP SOIL	0	1
M/S (mailing address)	Red sd w/ clay	1	18
WELL LOCATION:	Med yellow sd	18	30
sec 29 T 80 N S R 5 E W	Yellow CLAY	30	32
3 1/2 miles SSE of DENHAM (distance) (direction) (nearest town)	Fine white sd	32	43
WELL PURPOSE: Home (home, irrigation, municipal, industrial)	Pink + white CLAY	43	45
WELL COMPLETION DATA:	white CLAY	45	50
(1) diameter (inches) 2"	Coarse white SAND	50	53
(2) total depth (feet) 110	white CLAY	53	56
(3) static water level (feet) 67 below top of ground.	Coarse white sd	56	65
(4) casing PVC, 105 (material) (depth)	white + PINK CLAY	65	73
(size) If telescope see back.	Med yellow sd	73	78
(5) screen 5' 105 (length) (depth to top)	Coarse white sd	78	83
(size) PVC (material)	white CLAY	83	85
(6) pump 1 (HP) 7 (yield gpm)	Pea gravel	85	86
(type power) Elect	white CLAY	86	87
(7) electric log NO (yes or no)	Pea gravel w/ white pl	87	94
(organization running log)	Pea gravel w/		
(8) how well bottom plugged 2" CAP	Coarse white sd	94	110

DRILLERS REMARKS: Still in SAND when quit

DEPT. OF NATURAL RESOURCES  
BUREAU OF LAND & WATER RESOURCES  
JUN 16 1983  
RECEIVED

If well telescopes please sketch and show depths.

GROUND LEVEL

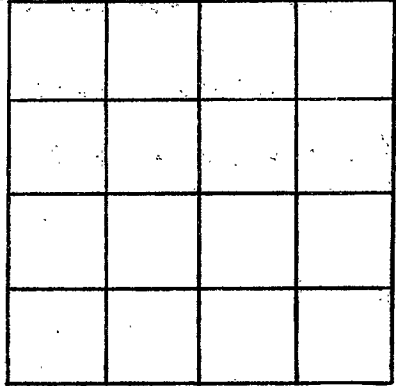

SECTION \_\_\_\_\_

Please indicate well location X.

ADDITIONAL INFORMATION

If more than one screen, show locations of each on sketch.