

MISSISSIPPI DEPARTMENT OF NATURAL RESOURCES

Bureau of Land and Water Resources

Southport Mall

P.O. Box 10631

Jackson, Mississippi 39209

WATER WELL DRILLERS LOG

Wayne
P
202A

11/19/84 date well completed 19 CARR'S WELL SERVICE WAYNE firm name county well located

LANDOWNER: GRAY MCRAE
RT 4 WAYNESBORO
MISS 39367
(mailing address)

WELL LOCATION:
sec. 6 T 8 N R 5 E
7 miles E of WAYNESBORO
(distance) (direction) (nearest town)

WELL PURPOSE: HOME
(home) irrigation, municipal, industrial

- WELL COMPLETION DATA:
- (1) diameter (inches) 2 1/2
 - (2) total depth (feet) 145
 - (3) static water level (feet) 36' below top of ground.
 - (4) casing 2 1/2" (material) 145' (depth)
2 1/2" (size) if telescope see back.
 - (5) screen OPEN HOLE (length) (depth to top)
2 1/2" (size) (material)
 - (6) pump 1 (HP) 8 GPM (yield gpm)
ELEC (type power)
 - (7) electric log NO (yes or no)
 - (8) how well bottom plugged OPEN

description of formations encountered	from	to
TOP SOIL	0	1
YELLOW SD	1	21
YELLOW WHITE CLAY	21	28
BLUE MARL	28	38
ROCK & GRAY	38	41
LIME ROCK	41	43
SOFT LIME	43	45
SEA SHELLS	45	48
H LIME ROCK	48	51
SOFT LIME	51	55
HARD LIME ROCK	55	61
SOFT LIME	61	65
GRAY CLAY	65	113
HARD LIME ROCK	113	116
SOFT LIME ROCK	116	119
HARD LIME ROCK	119	123
MED. LIME ROCK	123	124
HARD LIME ROCK	124	126
SOFT LIME ROCK	126	145

DEPT OF NATURAL RESOURCES
BUREAU OF LAND & WATER RESOURCES


NOV 16 1984

RECEIVED

DRILLERS REMARKS:

If well telescopes please sketch and show depths.

GROUND LEVEL

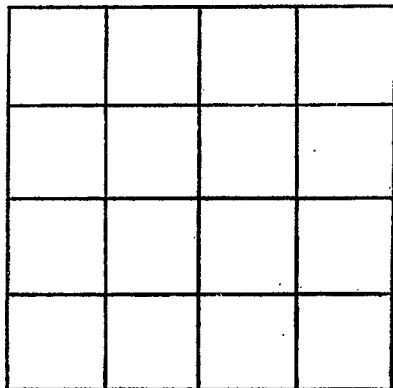

SECTION _____

Please indicate well location X.

ADDITIONAL INFORMATION

If more than one screen, show locations of each on sketch.