

Wayne
P
2030

MISSISSIPPI
BOARD OF WATER COMMISSIONERS
416 North State Street
Jackson, Mississippi 39201

WATER WELL DRILLERS LOG

3-1984 date well completed
84 McDonald Hill Farm firm name
Wayne county well located

LANDOWNER: Lessie Jordan
Rt # 2 Box 290
Waynesboro, Miss
(mailing address)

description of formations encountered	from	to
<u>Clay</u>	<u>0</u>	<u>18</u>
<u>Course sand</u>	<u>18</u>	<u>91</u>

WELL LOCATION:
sec. 23 T. 4 N. R. 5 E
1 miles East of Waynesboro
(distance) (direction) (nearest town)

WELL PURPOSE: None
(home, irrigation, municipal, industrial)

WELL COMPLETION DATA:

(1) diameter (inches) 2"

(2) total depth (feet) 91'

(3) static water level (feet) 58 below top of ground.

(4) casing 2" PVC 81'
(material) (depth)

_____ If telescope see back.
(size)

(5) screen 10' 81'
(length) (depth to top)

2" #12 PVC
(size) (material)

(6) pump _____ 10
(HP) (yield gpm)

_____ (type power)

(7) electric log _____
(yes or no)

_____ (organization running log)

(8) how well bottom plugged 2" back
pressure valve

DRILLERS REMARKS: None


DEPT OF NATURAL RESOURCES
BUREAU OF LAND & WATER RESOURCES

APR - 2 1984

RECEIVED

If well telescopes please sketch and show depths.

GROUND LEVEL

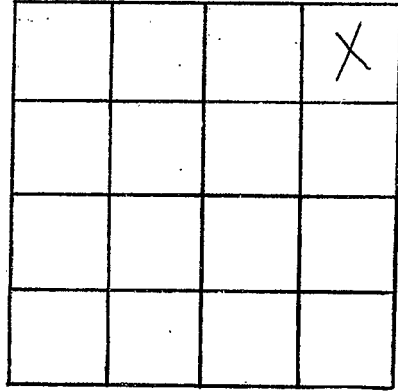

SECTION 23

Please indicate well location X.

ADDITIONAL INFORMATION

Lined area for additional information.

If more than one screen, show locations of each on sketch.