

Wayne
P
2031

MISSISSIPPI
BOARD OF WATER COMMISSIONERS
416 North State Street
Jackson, Mississippi 39201
WATER WELL DRILLERS LOG

1-12-84 1984 CARRS Well Service WAYNE
date well completed firm name county well located

LANDOWNER: Zinn Rest Church

description of formations encountered from to

Rt 1 BUCKATUNNA MS

TOP SD. L	0	1
RED. SD.	1	20
MED. VEL. SD.	20	25
CP. WH. SD.	25	34
WH. CLAY	34	50
PK. WH. "	50	56
WH. "	56	66
WH. PK. "	66	70
PK. VEL. "	70	75
PK. WH. "	75	85
" " "	85	95
PK. "	95	110
BLUISH "	110	115
PK. "	115	127
RED. SD. ROCK	127	130
MED. WH. SD.	130	140
C. ROUSE WH. SD.	140	160

(mailing address)

WELL LOCATION:

sec 33 T 50 N R 5 E
S W
1 miles north of Progress
(distance) (direction) (nearest town)

WELL PURPOSE: CHURCH
(home, irrigation, municipal, industrial)

WELL COMPLETION DATA:

- (1) diameter (inches) 2"
- (2) total depth (feet) 160
- (3) static water level (feet) 110 ^{below} above top of ground.
- (4) casing PVC 150
(material) (depth)
If telescope see back.
(size)
- (5) screen 10' 150
(length) (depth to top)
2" PVC
(size) (material)
- (6) pump 2 7
(HP) (yield gpm)
Elect
(type power)
- (7) electric log N/O
(yes or no)

(organization running log)

(8) how well bottom plugged 2" CAP

DEPT. OF NATURAL RESOURCES
BUREAU OF LAND & WATER RESOURCES


DRILLERS REMARKS:

FEB - 2 1984

RECEIVED

If well telescopes please
sketch and show depths.

GROUND LEVEL

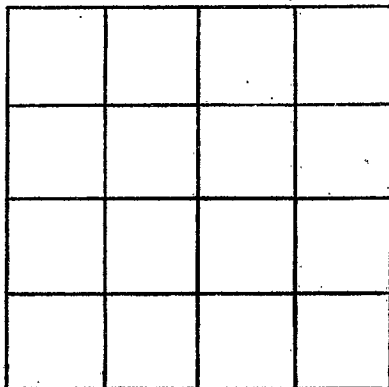

SECTION _____

Please indicate well location X.

ADDITIONAL INFORMATION

If more than one screen,
show locations of each on sketch.