

Wayne
P
2032

MISSISSIPPI DEPARTMENT OF NATURAL RESOURCES
Bureau of Land and Water Resources
Southport Mall
P.O. Box 10631
Jackson, Mississippi 39209
WATER WELL DRILLERS LOG

8-24 1984 CAPP'S WELL SER WAYNE
date well completed firm name county well located

LANDOWNER: MARILYN TAYLOR

RT. 1 BUCKATUNNA

MS. 39322

(mailing address)

WELL LOCATION:

sec. 15 T 8 N R 5 E
S W
4 miles N of PROGRESS
(distance) (direction) (nearest town)

WELL PURPOSE:

(home, irrigation, municipal, industrial)

WELL COMPLETION DATA:

- (1) diameter (inches) 2"
(2) total depth (feet) 120
(3) static water level (feet) 82 below
top of ground.
(4) casing P.V.C. 115'
(material) (depth)
2" If telescope see back.
(size)
(5) screen 5' 115'
(length) (depth to top)
2" P.V.C.
(size) (material)
(6) pump 1 8
(HP) (yield gpm)
ELEC
(type power)
(7) electric log NO
(yes or no)

(organization running log)

(8) how well bottom plugged CAPPED

description of formations
encountered

from

to

TOP SOIL	0	2
RD. SD. WT. CLAY	2	27
BROWN G/W. SD. & W. CL.	27	35
PK. & WH. SD.	35	82
MED BR. SD.	82	85
PK. & WH. SAND	85	87
MED WH.	87	100
C.R. WH.	100	120

DEPT. OF NATURAL RESOURCES
BUREAU OF LAND & WATER RESOURCES


SEP - 4 1984

RECEIVED

DRILLERS REMARKS:

If well telescopes please
sketch and show depths.

GROUND LEVEL

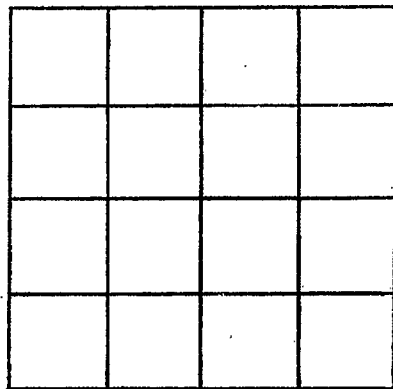

SECTION _____

Please indicate well location X.

ADDITIONAL INFORMATION

If more than one screen,
show locations of each on sketch.