

MISSISSIPPI DEPARTMENT OF NATURAL RESOURCES

Bureau of Land and Water Resources

Southport Mall

P.O. Box 10631

Jackson, Mississippi 39209

WATER WELL DRILLERS LOG

WAYNE
P 2033

Dec 3 1985 Porter Drilling & Log Wayne
date well/completed firm name county well located

LANDOWNER: Mr. Elvain
Automatic Sprinkler Co.
At 211 Agnesboro Ms.
(mailing address)

WELL LOCATION:
sec. 6 T. 20 N. R. 5 E
6 miles East of Hammond
(distance) (direction) (nearest town)

WELL PURPOSE: Home
(home, irrigation, municipal, industrial)

- WELL COMPLETION DATA:
- (1) diameter (inches) 2"
 - (2) total depth (feet) 140'
 - (3) static water level (feet) 71' below top of ground.
 - (4) casing steel 133'
(material) (depth)
2' if telescope see back.
(size)
 - (5) screen none used
(length) (depth to top)
(size) (material)
 - (6) pump 2 12
(HP) (yield gpm)
elec
(type power)
 - (7) electric log no
(yes or no)
(organization running log)
 - (8) how well bottom plugged open

description of formations encountered	from	to
<u>sand</u>	<u>0</u>	<u>17</u>
<u>Clay & sand</u>	<u>17</u>	<u>27</u>
<u>sand</u>	<u>27</u>	<u>42</u>
<u>Clay</u>	<u>42</u>	<u>49</u>
<u>rock & strata</u>	<u>49</u>	<u>58</u>
<u>Clay</u>	<u>58</u>	<u>111</u>
<u>interbedded rock</u>	<u>111</u>	<u>135</u>
<u>with clay</u>	<u>135</u>	<u>140</u>

105' 1 1/2" galv. down pipe

3 1/2' 3 way coupling set at 111' with 21' 2" casing below making 112' 2" cas
above basement

RECEIVED


FEB 11 1986

Department of Natural Resources
Bureau of Land & Water Resources

DRILLERS REMARKS:

If well telescopes please sketch and show depths.

GROUND LEVEL

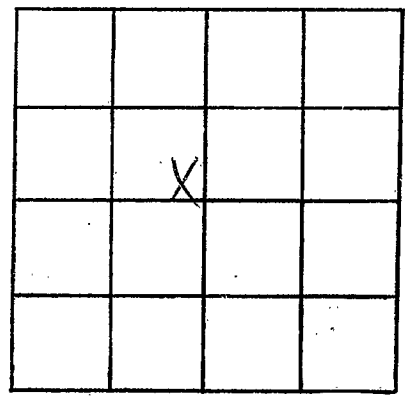

SECTION 6

Please indicate well location X.

ADDITIONAL INFORMATION

Lined area for additional information.

If more than one screen, show locations of each on sketch.