

MISSISSIPPI DEPARTMENT OF NATURAL RESOURCES

Bureau of Land and Water Resources

Southport Mall

P.O. Box 10631

Jackson, Mississippi 39209

WATER WELL DRILLERS LOG

WAYNE  
P. 2004

10/17 1986 CARR'S WELL SER. WAYNE  
date well completed firm name county well located

LANDOWNER: <u>CURTIS CHAMBERS</u>	description of formations encountered	from	to
<u>Rt. 1 BOGATONNA,</u> <u>Ms.</u> (mailing address)			
<b>WELL LOCATION:</b> sec. <u>4 T 8 N S</u> R. <u>10 E W</u> <u>3</u> miles <u>E</u> of <u>DENTHAM</u> (distance) (direction) (nearest town)	<u>SD &amp; CLAY</u>	<u>0</u>	<u>8</u>
	<u>CHALK</u>	<u>8</u>	<u>22</u>
	<u>SD &amp; CH. STRATA</u>	<u>22</u>	<u>60</u>
	<u>MED COARSE SD.</u>	<u>60</u>	<u>85</u>
	<u>CLAY &amp; SD.</u>	<u>85</u>	<u>89</u>
	<u>SD &amp; CHALK</u>	<u>89</u>	<u>107</u>
	<u>CHALK</u>	<u>107</u>	<u>113</u>
<b>WELL PURPOSE:</b> (home, irrigation, municipal, industrial)			
<b>WELL COMPLETION DATA:</b>			
(1) diameter (inches) <u>2"</u>			
(2) total depth (feet) <u>85'</u>			
(3) static water level (feet) <u>60</u> <u>below</u> top of ground.			
(4) casing <u>PVC</u> <u>60</u> (material) (depth) <u>2"</u> If telescope see back. (size)			
(5) screen <u>5'</u> <u>80</u> (length) (depth to top) <u>2"</u> <u>PVC</u> (size) (material)			
(6) pump <u>1</u> <u>9</u> (HP) (yield gpm) <u>ELEC</u> (type power)			
(7) electric log <u>NO</u> (yes or no)  (organization running log)			
(8) how well bottom plugged <u>B.W.V.</u> <u>RIVERSEA L.H. NIPPLE</u>			
<b>DRILLERS REMARKS:</b> <u>PULLED</u> <u>BACK TO 85'</u>			


RECEIVED

NOV 13 1986

Department of Natural Resources  
Bureau of Land & Water Resources

If well telescopes please  
sketch and show depths.

GROUND LEVEL

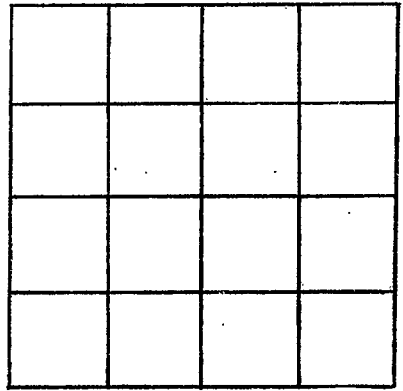

SECTION \_\_\_\_\_

Please indicate well location X.

ADDITIONAL INFORMATION

If more than one screen,  
show locations of each on sketch.