

MISSISSIPPI DEPARTMENT OF NATURAL RESOURCES

Bureau of Land and Water Resources

COUNTY WELL LOCATED WAYNE	
WELL NUMBER P	CODED
2035	
DATE WELL COMPLETED 3/6/87	

PERMIT NUMBER 0-205
NAME OF DRILLING FIRM CARR'S WELL SER
Buckatunga, MS.

P.O. Box 10631
Jackson, Mississippi 39209
WATER WELL DRILLERS LOG

NAME & MAILING ADDRESS OF LANDOWNER DIXIE PUCKETT			
RT. 3			
WAYNESBORO, MS. 39367			
WELL LOCATION:	SEC	TOWNSHIP	RANGE
WAYNE	30	8 ^N _S	5 ^E _W
DISTANCE	DIRECTION	NEAREST TOWN	
2 Miles	S	of WAYNESBORO	
OTHER LANDMARK DN RIVER BANK			
WELL PURPOSE: Home, Irrigation, Municipal, Industrial, Fish Pond, etc. HOME			

PUMP DATA		
PUMP TYPE (Circle One): Submersible, Turbine, <u>Jet</u> Flowing Well, Other (Describe) _____		
POWER TYPE (Circle One): <u>Electric</u> , Tractor, Diesel, Gasoline, Butane, Other (Describe) _____		
Pump Capacity (GPM) 12	No. of Stages 1	Setting Depth 25 FT.
PUMP TEST		
Well yielded 12 GPM with a drawdown of 4 ft. after 1 hours of pumping		

WELL DATA		
Well Depth 88'	Casing Diameter (In.) 2"	Casing Length (Ft.) 83
Type of Casing PVC	Hole Depth 88	Depth to Static Water Level 8'
TYPE OF COMPLETION: (Circle One or More): Gravel Packed, Underreamed, Telescoped, Natural Development, Open Hole, Other (Describe) SAND PACKED		
Top of Lap Pipe or Reduction in Casing NONE FEET		
IF TELESCOPED OR MORE THAN ONE SCREEN: USE BACK PAGE		

LOG DATA	
TYPE OF LOG RUN (Circle One): Electric, Gamma Ray, Density, Sonic, Neutron, Other (Describe) <u>No Log Run</u>	
Name of Organization Running Log	

SCREEN DATA		
Diameter - Inches 2"	Length - Feet 5'	Slot Size - Inches 6
Screen Type PVC	Depth to Bottom - Feet 89	


GEOLOGIC DATA (Office Use Only)			
Surface Elev.	Geologic Unit	Unit Thickness	Depth to Top
Subs. SWL	Date	Analysis	Aquifer Test

Driller's Remarks	

DESCRIPTION OF FORMATIONS ENCOUNTERED	FROM	TO	FORMATIONS (Continued)	FROM	TO
TOP SOIL	0	1	<div style="font-size: 2em; font-weight: bold; opacity: 0.5;">RECEIVED</div> <p style="font-size: 1.5em; font-weight: bold;">APR 20 1987</p> <p style="font-size: 0.8em;">Department of Natural Resources Bureau of Land & Water Resources</p>		
SD + CLAY	1	30			
BLUE CLAY	30	34			
ROCK STRATOR	34	39			
BLUE CHALK	39	54			
ROCK STRATOR	54	55			
BLUE CLAY	55	60			
ROCK	60	69			
BLUE CLAY	69	72			
FINE SD.	72	88			
IF MORE SPACE IS NEEDED, USE BACK					

If well telescopes please sketch and show depths.

GROUND LEVEL

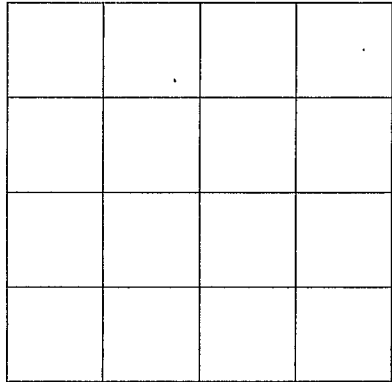

SECTION _____

Please indicate well location X.

ADDITIONAL INFORMATION

Lined area for providing additional information.

If more than one screen, show location of each on sketch.