

WAYNE MISSISSIPPI BOARD OF WATER COMMISSIONERS

Q2

6-20-62

WATER WELL DRILLERS LOG

Date: 6/20, 1962, Driller: C.P. Clark, County: Wayne

(Name)

(1) Owner of Land:	Description & Color of Materials	Thick- ness Feet	Depth Feet
U.S. Forest Service	0-10 Red Clay	10	
Jackson, Miss.	10-15 Sandy Clay	5	
(Address)	15-45 Grey Clay	30	
(2) Location: SW 1/4, NW 1/4, Sec. 34 T. 9 R. 23	45-75 Grey Sand	30	
SF	75-125 Blue Clay	50	
2.3 miles of LAUREL	125-145 sand & Clay Strata	17	
(3) Topography: (Hilly) (Flat) (Level)	145-152 fine sand	9	
(4) Purpose of Well: (Domestic Irrigation) (Municipal, Industrial, Other)	52-155 Blue Clay	3	
	155-164 Sand fine	9	
	164-175 mixed O.S.	11	
	175-206 sand	31	
	206-211 Blue Clay	05	

Information upon completion of well:

- (1) Diameter 4 inches.
- (2) Total Depth 206 feet.
- (3) Water Level 101 feet below top of ground.
- (4) Cased to 195' 6" Size 4
- (5) Screen: Size 4 Length 10 1/2
- (6) Were any formations sealed against pollution? yes, no.

If YES depth of formation 50


Why to keep surface water out

Drillers Remarks: Well produced

140 g.p.m. with 5 ft drawdown

pH 6.0, Sp. and 15, Fe 6-7

2 HP sub pump

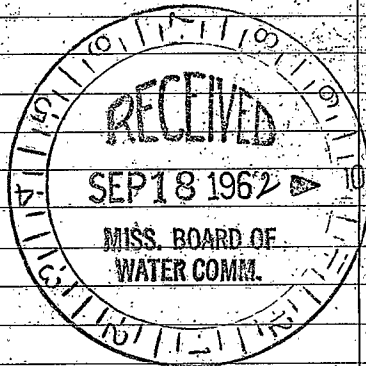

(Use Back Side)

Well No.

Wagon

C. D. Bank 1/30

U.S. Forest Service

0-10
 10-12
 12-14
 14-16
 98-100

air, head

1000

1

4

100

101

102

103

104

to keep
 with
 1000
 1000