

**MISSISSIPPI
BOARD OF WATER COMMISSIONERS**
416 North State Street
Jackson, Mississippi 39201

WATER WELL DRILLERS LOG

Wayne
96
8-67

Aug 21 19 *67* *Porter Drilling & Log* *Wayne*
date well completed firm name county well located

LANDOWNER: *R. J. Mc New*

description of formations encountered	from	to
<i>red clay</i>	<i>0</i>	<i>12</i>
<i>sand & some pea gravel</i>	<i>12</i>	<i>32</i>
<i>mostly chalk</i>	<i>32</i>	<i>60</i>
<i>red sand</i>	<i>60</i>	<i>63</i>
<i>red loose chalk</i>	<i>63</i>	<i>93</i>
<i>red sand</i>	<i>93</i>	<i>109</i>
<i>stayed on chalk</i>		

At 4 Waynesboro, Miss
(mailing address)

WELL LOCATION:
sec *25* T *9* (N) R *7* (E)
3 miles *S* of *Waynesboro*
(distance) (direction) (nearest town)

WELL PURPOSE: *home*
(home, irrigation, municipal, industrial)


WELL COMPLETION DATA:

- (1) diameter (inches) *2"*
- (2) total depth (feet) *108*
- (3) static water level (feet) *95'* below top of ground.
- (4) casing *steel*, *105'*
(material) (depth)
2" if telescope see back.
(size)
- (5) screen *3'*, *105'*
1 1/4" (length) (depth to top)
S.S.
(size) (material)
- (6) pump *1/2*, *3 1/2*
(HP) (yield gpm)
elec
(type power)
- (7) electric log *no*
(yes or no)

(organization running log)


(8) how well bottom plugged
flush joint

DRILLERS REMARKS:

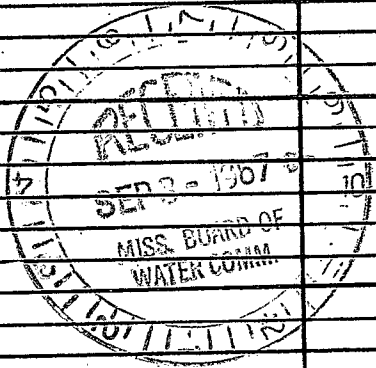

If well telescopes please sketch and show depths.

GROUND LEVEL

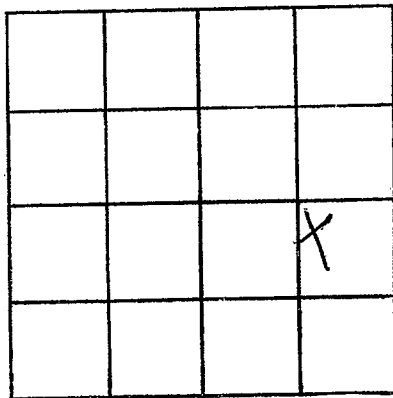

SECTION 25

Please indicate well location X.

ADDITIONAL INFORMATION

If more than one screen,
show locations of each on sketch.