

Wayne

MISSISSIPPI BOARD OF WATER COMMISSIONERS

+ U.S. Forest Service

Case # 24169
Wayne

WATER WELL DRILLERS LOG

Date: 5/1, 1964, Driller: C.P. Clark

County: Wayne

(Name)

CODED

(1) Owner of Land: U.S. Forest Service

Jackson Miss (Name)

34 7N9W (Address)

(2) Location: 1/4, 1/4, Sec. T R

23 miles S.E. of Laurel (distance) (direction) (Nearest Town)

(3) Topography: X (Hilly) (Flat) (Level)

(4) Purpose of Well: Rec. Park (Thompson) (Domestic Irrigation) (Municipal, Industrial, Other)

Description & Color of Materials Sand, Clay, Red Clay, Shell, etc.

Thick-ness Feet

Depth Feet

0-8 Grey Clay	8	
8-26 white sand	18	
26-75 mixed clay	49	
75-173 Sand	98	

Information upon completion of well:

(1) Diameter 2 inches.

(2) Total Depth 173 feet.

(3) Water Level flow feet below top of ground.

(4) Cased to 168, Size 2 in

(5) Screen: Size 1 1/4, Length 5 ft


(6) Were any formations sealed against pollution? yes, no.

If YES depth of formation 3 ft

Why avoid surface water

Drillers Remarks:

CODED

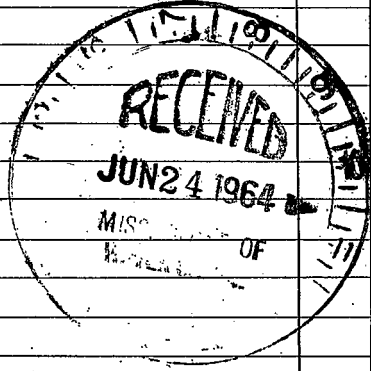

Well No.

(Use Back Side)

