

Wayne
Q 8
5-13-70

MISSISSIPPI
BOARD OF WATER COMMISSIONERS
416 North State Street
Jackson, Mississippi 39201

WATER WELL DRILLERS LOG

May 13 1970 Roy Westwaterwells Wayne
date well completed firm name county well located

LANDOWNER: Danny Nickelson
RT 2
Richston Miss
(mailing address)

description of formations encountered	from	to
clay	0	28
sand	28	50

WELL LOCATION:
sec 35 T 2 N R 9 E 194
20 miles S.E. of Laurel
(distance) (direction) (nearest town)

WELL PURPOSE: home
(home, irrigation, municipal, industrial)

- WELL COMPLETION DATA:
- (1) diameter (inches) 2 in
 - (2) total depth (feet) 50
 - (3) static water level (feet) 45 below top of ground.
 - (4) casing galv 50 (material) (depth)
 - (size) If telescope see back.
 - (5) screen 5/8 45 (length) (depth to top)
 - 1/4 steel (size) (material)
 - (6) pump 1/2 5 (HP) (yield gpm)
 - Rea (type power)
 - (7) electric log NO (yes or no)

(organization running log)
(8) how well bottom plugged Washable


MAY 20 1970

Misc. DD. OF WA

DRILLERS REMARKS:

If well telescopes please sketch and show depths.

GROUND LEVEL

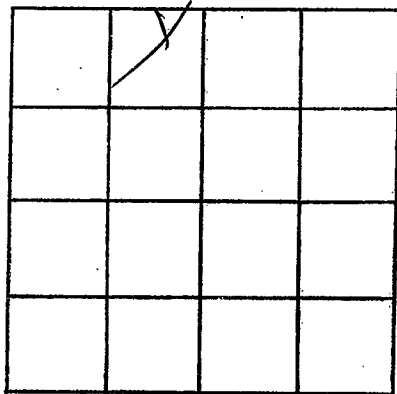

SECTION

35

Please indicate well location X.

ADDITIONAL INFORMATION

If more than one screen,
show locations of each on sketch.