

WAYNE
Q9
9-9-70

MISSISSIPPI
BOARD OF WATER COMMISSIONERS
416 North State Street
Jackson, Mississippi 39201

CODED

WATER WELL DRILLERS LOG

Sept 9 1970 Ray West Water Wells Co Wayne
date well completed firm name county well located

LANDOWNER: Richardson
RT 4 Laurel Miss
(mailing address)

WELL LOCATION:
sec. 15 T. 7 N. R. 9 E
2.5 miles S of Laurel Miss
(distance) (direction) (nearest town)

WELL PURPOSE: home
(home, irrigation, municipal, industrial)

- WELL COMPLETION DATA:
- (1) diameter (inches) 2 in
 - (2) total depth (feet) 243
 - (3) static water level (feet) 55 below above top of ground.
 - (4) casing galv 233 (material) (depth)
 - (size) if telescope see back.
 - (5) screen 10 233 (length) (depth to top)
1 1/4 St steel (size) (material)
 - (6) pump 1/2 9 (HP) (yield gpm)
Rea (type power)
 - (7) electric log NO (yes or no)
 - (organization running log)
 - (8) how well bottom plugged Wash water

description of formations encountered	from	to
Clay	0	8
sandy clay	8	25
Clay	25	22
sandy clay	22	90
Clay	90	150
fine sand	150	170
Clay	170	220
Road	220	243

CODED


OCT 2 1970

MISS. BD. OF
WATER COMMISSIONERS

DRILLERS REMARKS:

If well telescopes please sketch and show depths.

GROUND LEVEL

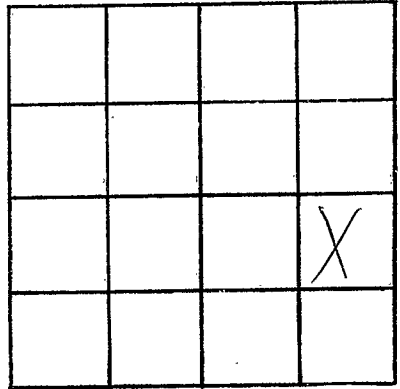

SECTION 15

Please indicate well location X.

ADDITIONAL INFORMATION

If more than one screen,
show locations of each on sketch.