

MISSISSIPPI  
BOARD OF WATER COMMISSIONERS  
416 North State Street  
Jackson, Mississippi 39201

**CODED**

WATER WELL DRILLERS LOG

June 1970 date well completed  
Peoples Drilling Co. firm name  
Wayne county well located

LANDOWNER: Charles Bradley  
Rt 2  
Richton, Miss.  
(mailing address)

description of formations encountered	from	to
yellow sandy clay + small sand streaks	0	42
Blue Clay	42	73
White Sand	73	90

WELL LOCATION:  
sec. 34 T. 7 N. R. 9 W.  
6 1/2 miles S of Sloughport  
(distance) (direction) (nearest town)

WELL PURPOSE: Home  
(home, irrigation, municipal, industrial)

**CODED**

WELL COMPLETION DATA:

- (1) diameter (inches) 2
- (2) total depth (feet) 90
- (3) static water level (feet) 58 (below top of ground)
- (4) casing Galv. 84 (material), (depth)  
2" (size) if telescope see back.
- (5) screen 6' 84' (length), (depth to top)  
2" stainless steel (size), (material)
- (6) pump 1/2 7 (HP), (yield gpm)  
electric (type power)
- (7) electric log No (yes or no)  
(organization running log)
- (8) how well bottom plugged Back  
wash hole


DRILLERS REMARKS:

JUL 2 1970

MISS. BD. OF

If well telescopes please sketch and show depths.

GROUND LEVEL

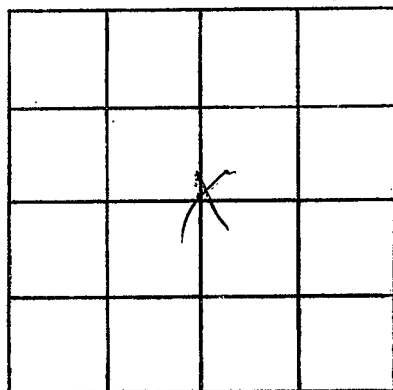

SECTION 34

Please indicate well location X.

ADDITIONAL INFORMATION

If more than one screen,  
show locations of each on sketch.