

Wayne  
Q 11  
6-70

MISSISSIPPI  
BOARD OF WATER COMMISSIONERS  
416 North State Street  
Jackson, Mississippi 39201

**CODED**

WATER WELL DRILLERS LOG

June 19 70 Peoples Drilling Co Wayne  
date well completed firm name county well located

LANDOWNER: William Cooley

description of formations encountered	from	to
yellow sandy clay	0	38
yellow sand	38	45
blue sandy clay + sand streak	45	72
yellow + multi-colored sand coarse	72	130

Rt 3  
Waynesboro Miss  
(mailing address)

WELL LOCATION:  
sec 13 T 70 N R 9 W  
5 miles SE of Hollyfield  
(distance) (direction) (nearest town)

WELL PURPOSE: Fish Pond  
(home, irrigation, municipal, industrial)

- WELL COMPLETION DATA:
- (1) diameter (inches) 4
  - (2) total depth (feet) 130
  - (3) static water level (feet) 36 below top of ground.
  - (4) casing Iron 120 (material) (depth)  
4" (size) If telescope see back.
  - (5) screen 5' 12-5 (length) (depth to top)  
2" Stainless steel (size) (material)
  - (6) pump 3 30 (HP) (yield gpm)  
elect Air Comp. (type power)
  - (7) electric log NO. (yes or no)

**CODED**

(organization running log)  
(8) how well bottom plugged Back  
Work below


JUL 2 1970

DRILLERS REMARKS:

MISS. BD. OF  
WATER COMM.

If well telescopes please sketch and show depths.

GROUND LEVEL

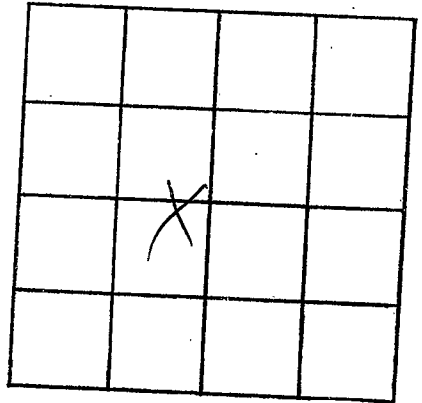

SECTION 13

Please indicate well location X.

ADDITIONAL INFORMATION

If more than one screen,  
show locations of each on sketch.