

MISSISSIPPI
BOARD OF WATER COMMISSIONERS
416 North State Street
Jackson, Mississippi 39201

WATER WELL DRILLERS LOG

CODED

WAYNE
Q 13
6-3-71

June 3 1971 Ray West Water Wells Wayne
date well completed firm name county well located

LANDOWNER: Melvin Strickland
Rt 4 Laurel Miss
Box 202
(mailing address)

description of formations encountered	from	to
	Clay	0
Sand	8	28
Clay	28	70
Sand	70	105

WELL LOCATION:
sec. 15 T 7 N R 9 E
2.0 miles S.E. of Laurel
(distance) (direction) (nearest town)

WELL PURPOSE: Home
(home, irrigation, municipal, industrial)

- WELL COMPLETION DATA:
- (1) diameter (inches) 2
 - (2) total depth (feet) 105
 - (3) static water level (feet) 52 below above top of ground.
 - (4) casing Galv 100 (material) (depth)
 - (5) screen 5ft 100 (length) (depth to top)
 - 1 1/2 St steel (size) (material)
 - (6) pump 1 10 (HP) (yield gpm)
 - Rea (type power)
 - (7) electric log 70 (yes or no)
 - (organization running log)
 - (8) how well bottom plugged Washed

CODED


III 6 1971

DRILLERS REMARKS:

MISS. BD. OF WATER COMMISSIONERS

If well telescopes please sketch and show depths.

GROUND LEVEL

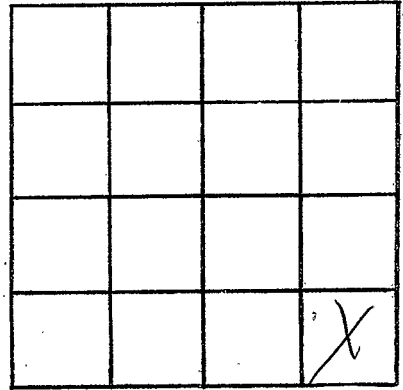

SECTION 15

Please indicate well location X.

ADDITIONAL INFORMATION

If more than one screen, show locations of each on sketch.