

WAYNE
Q 14
5-29-71

MISSISSIPPI
BOARD OF WATER COMMISSIONERS
416 North State Street
Jackson, Mississippi 39201

CODED

WATER WELL DRILLERS LOG

May 29 1971 Booth Drilling & Supply Wayne
date well completed firm name county well located

LANDOWNER: Elbert Gelf

description of formations encountered	from	to
red clay & chert	0	40
blue chert	40	106
river sand & chert	106	135
blue chert	135	152
sand & chert streaks	152	162
blue chert	162	207
not course sand	207	219
colored white stuff		
in sand		

At Magnolia mine
(mailing address)

WELL LOCATION:
sec. 4 T. 70 N. R. 9 E.
1 miles SW of Shreveport
(distance) (direction) (nearest town)

WELL PURPOSE: home
(home, irrigation, municipal, industrial)

WELL COMPLETION DATA:

- (1) diameter (inches) 2"
- (2) total depth (feet) 219'
- (3) static water level (feet) 30' below top of ground.
- (4) casing steel 212'
(material) (depth)
- 2" if telescope see back.
(size)
- (5) screen 6' 213'
1/4" (length) (depth to top)
609a S.S.
(size) (material)
- (6) pump orow-to set pump
(HP) (yield gpm)
- (type power)
- (7) electric log (yes or no)
- (organization running log)
- (8) how well bottom plugged flush sand

6' 1/4 60 gal S.S. with
3' 1/4' long best
with gracker

CODED


DRILLERS REMARKS:

JUL 14 1971

MISSISSIPPI BOARD OF WATER COMMISSIONERS

If well telescopes please sketch and show depths.

GROUND LEVEL

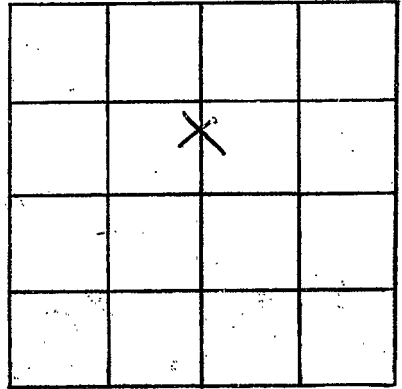

SECTION 4

Please indicate well location X.

ADDITIONAL INFORMATION

If more than one screen, show locations of each on sketch.