

WAYNE  
Q 17  
12-6-71

MISSISSIPPI  
BOARD OF WATER COMMISSIONERS  
416 North State Street  
Jackson, Mississippi 39201


WATER WELL DRILLERS LOG

Dec 6 1971 Risen Water Well Wayne  
date well completed firm name county well located

LANDOWNER:	description of formations encountered	from	to
Lela B. Davis Rt. 1, Buckatanna, Miss. (mailing address)	Top soil white chault fine white to coarse sand	0 2 10	2 10 35
WELL LOCATION: sec. 19 T 7 <sup>N</sup> S R 5 E 2 miles north east of Buckatanna (distance) (direction) (nearest town)	Total	38	feet
WELL PURPOSE: Home (home, irrigation, municipal, industrial)			
WELL COMPLETION DATA:			
(1) diameter (inches) 4"			
(2) total depth (feet) 35'			
(3) static water level (feet) 18' below top of ground.			
(4) casing 2" (material), 32' (depth)			
If telescope see back.			
(5) screen 3' (length), 35' (depth to top)			
1 1/2" Brass lined drive point (size) (material)			
(6) pump 1/2 (HP), 10 (yield gpm)			
Electric (type power)			
(7) electric log NO (yes or no)			
(organization running log)			
(8) how well bottom plugged drive point	JAN 6 1972		
DRILLERS REMARKS: Good	MISS. RD. OF WATER COMM.		

If well telescopes please sketch and show depths.

GROUND LEVEL

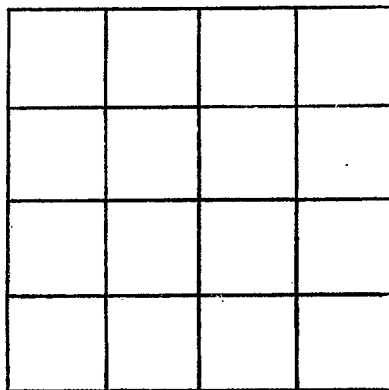

SECTION \_\_\_\_\_

Please indicate well location X.

ADDITIONAL INFORMATION

A series of horizontal lines for recording additional information, starting below the 'ADDITIONAL INFORMATION' header and extending to the bottom of the page.

If more than one screen, show locations of each on sketch.