

Wayne
Q 19
4-27-72

MISSISSIPPI
BOARD OF WATER COMMISSIONERS
416 North State Street
Jackson, Mississippi 39201

CODED

WATER WELL DRILLERS LOG

April 27 1972 Ray Winst Water wells Wayne
date well completed firm name county well located

LANDOWNER: Mac Stone
Stickland Pt 4
Laurel Miss
(mailing address)

description of formations encountered	from	to
clay	0	8
soil	8	20
clay	20	96
sandy clay	96	130
soil	130	165

WELL LOCATION:
sec. 22 T. 7 N. R. 9 E.
20 miles East of Clara
(distance) (direction) (nearest town)

WELL PURPOSE: home
(home, irrigation, municipal, industrial)

WELL COMPLETION DATA:

(1) diameter (inches) 2

(2) total depth (feet) 165

(3) static water level (feet) 110 below above top of ground.

(4) casing galv. 165
(material) (depth)

(size) If telescope see back.

(5) screen 5 160
(length) (depth to top)

1/4 st steel
(size) (material)

(6) pump 1/2 7
(HP) (yield gpm)

REA
(type power)

(7) electric log no
(yes or no)

(organization running log)

(8) how well bottom plugged crushed

CODED


JUN 10 1972

MISS. Bd. of
WATER COMMISSIONERS

DRILLERS REMARKS:

If well telescopes please sketch and show depths.

GROUND LEVEL

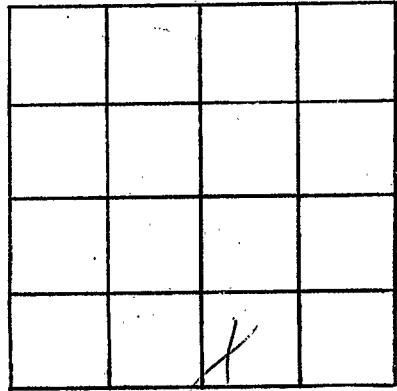

SECTION 22

Please indicate well location X.

ADDITIONAL INFORMATION

If more than one screen,
show locations of each on sketch.