

WAYNE

Q 21

9-5-72

MISSISSIPPI BOARD OF WATER COMMISSIONERS 416 North State Street Jackson, Mississippi 39201

CODED

WATER WELL DRILLERS LOG

Sept 5 1972 Roy West water wells wayne
days well completed firm name county well located

LANDOWNER

Charlie R. Mason
Rt 1 waynesboro MS 39098

Description of formations encountered

from to

Clay 0 3
Sand 3 26
Clay 26 45
Sand 45 76

(mailing address)

WELL LOCATION:

sec. 2 T 7 N R 9 E
2.0 miles S.E. of Laurel
(distance) (direction) (nearest town)

WELL PURPOSE: home
(home, irrigation, municipal, industrial)

WELL COMPLETION DATA:

- (1) diameter (inches) 2 in
(2) total depth (feet) 76
(3) static water level (feet) 3 below top of ground.
(4) casing plastic 71 (material) (depth)
(size) if telescope see back.
(5) screen 5 ft 71 (length) (depth to top)
1/4 St Steel (size) (material)
(6) pump 1 10 (HP) (yield gpm)
Rea (type power)
(7) electric log NO (yes or no)

CODED

(organization running log)


(8) how well bottom plugged washed

DRILLERS REMARKS:


SEP 12 1972

MISS. ST. WATER COM.

If well telescopes please sketch and show depths.

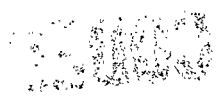

GROUND LEVEL

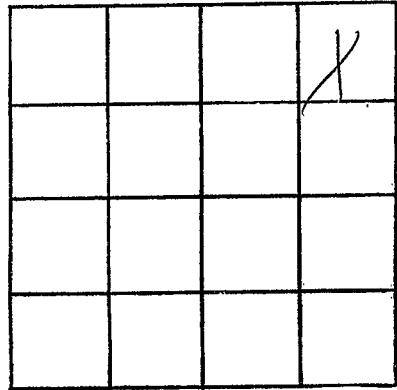

SECTION 2

Please indicate well location X.

ADDITIONAL INFORMATION

A series of horizontal lines for writing additional information, starting below the 'ADDITIONAL INFORMATION' header and extending to the bottom of the page.

If more than one screen, show locations of each on sketch.