

Wayne
Q 22
10-12-72

MISSISSIPPI
BOARD OF WATER COMMISSIONERS
C. P. CLARK
416 North State Street
Jackson, Mississippi 39201
WATER WELL DRILLING
ROUTE 2
WIREL, MISS, 39440
WATER WELL DRILLERS LOG

CODED

10/12 1972 date well completed
C. P. Clark firm name
Wayne county well located

LANDOWNER: Gerald Stephens
Rt # 2
Pikeblow Miss
(mailing address)

description of formations encountered	from to	
Sandy Clay	0	9
Sand	9	15
Clay	15	38
Sandy Clay	38	50
Sand	50	78

WELL LOCATION:
sec. 23 T. 7 N. R. 9 E. S. 4
4 miles S of Strengwood
(distance) (direction) (nearest town)

WELL PURPOSE: Home
(home, irrigation, municipal, industrial)

- WELL COMPLETION DATA:
- (1) diameter (inches) 12
 - (2) total depth (feet) 78
 - (3) static water level (feet) 21 below top of ground.
 - (4) casing Galv. Iron 13
(material) (depth)
 - _____ if telescope see back.
(size)
 - (5) screen 5 , 13
(length) (depth to top)
1/4 , Solid S.S. 006
(size) (material)
 - (6) pump 1/2 , 10
(HP) (yield gpm)
1100
(type power)
 - (7) electric log No
(yes or no)
 - _____ (organization running log)
 - (8) how well bottom plugged B w v

CODED


DRILLERS REMARKS: Set 10A
Get @ 42 ft

NOV 24 1972

MISS. Bd. of WATER COMMISSIONERS

If well telescopes please sketch and show depths.

GROUND LEVEL

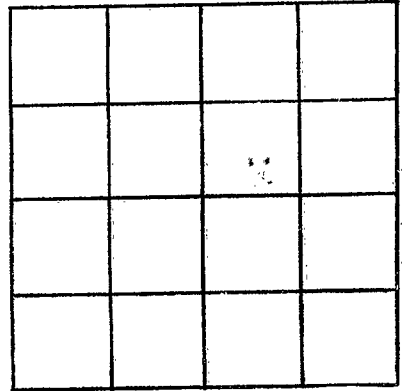

SECTION _____

Please indicate well location X.

ADDITIONAL INFORMATION

If more than one screen, show locations of each on sketch.