

WAYNE

Q 24

7-28-73

MISSISSIPPI BOARD OF WATER COMMISSIONERS 416 North State Street Jackson, Mississippi 39201

CODED

WATER WELL DRILLERS LOG

July 28 1973 Ray Wainwright Water Wells Wayne date well completed firm name county well located

LANDOWNER: Sherman Harrison Rt 1 Waynesboro (mailing address)

description of formations encountered	from	to
	Clay	0
Sand	12	28
Clay	28	35
Sand	35	50

WELL LOCATION: sec. 1 T 7 N R 9 E 20 miles S.E. of Laurel Miss (distance) (direction) (nearest town)

WELL PURPOSE: None (home, irrigation, municipal, industrial)

- WELL COMPLETION DATA:
- (1) diameter (inches) 2
 - (2) total depth (feet) 50
 - (3) static water level (feet) 15 below top of ground.
 - (4) casing galv #4 (material) (depth)
 - (5) screen 5 ft 45 (length) (depth to top) 1 1/2 (size) Stainless (material)
 - (6) pump 1 (HP) 13 (yield gpm) Rea (type power)
 - (7) electric log No (yes or no)

CODED


(organization running log) how well bottom plugged Washburn

DRILLERS REMARKS:

AUG 6 1973

If well telescopes please sketch and show depths.

GROUND LEVEL

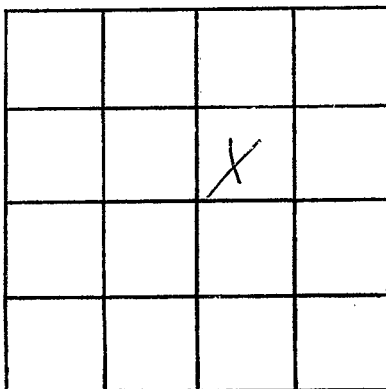

SECTION 1

Please indicate well location X.

ADDITIONAL INFORMATION

If more than one screen,
show locations of each on sketch.