

WAYNE
 025
 5-3-74

C. P. CLARK
 MISSISSIPPI WATER WELL DRILLING
 BOARD OF WATER COMMISSIONERS ROUTE 2
 416 North State Street LAUREL, MISS. 39440
 Jackson, Mississippi 39201

WATER WELL DRILLERS LOG CODED 3

5/3 1974 C.P. Clark Wayne
 date well completed firm name county well located

LANDOWNER: H.L. Bradley
 Rt # 2
 Richton, Miss
 (mailing address)

WELL LOCATION:
 sec 34 T 1 N S R 7 E W
 1 miles S of Sloughboro
 (distance) (direction) (nearest town)


WELL PURPOSE: Home
 (home, irrigation, municipal, industrial)

- WELL COMPLETION DATA:
- (1) diameter (inches) 2
 - (2) total depth (feet) 90
 - (3) static water level (feet) 83' below top of ground.
 - (4) casing Galvalume 85 (material) (depth)
 - (size) If telescope see back.
 - (5) screen 5 (length) 85 (depth to top)
 1 1/4 (size) Galval 55 (material)
 - (6) pump 1 (HP) 6 (yield gpm)
 220V (type power)
 - (7) electric log NO (yes or no)
 - (organization running log)
 - (8) how well bottom plugged Bwv

description of formations encountered	from	to
		IG
Red Sandy Clay	0	17
Sand	17	34
Clay	39	65
Mipid Sandy Clay	65	75
Sand	75	90


CODED

DRILLERS REMARKS: Sit 12A
 Rt @ 836

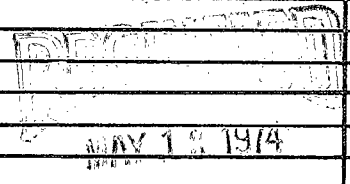

If well telescopes please sketch and show depths.

GROUND LEVEL

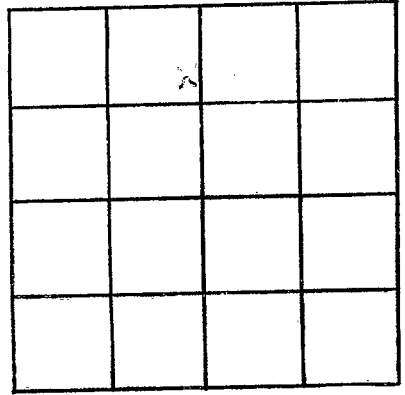

SECTION _____

Please indicate well location X.

ADDITIONAL INFORMATION

If more than one screen, show locations of each on sketch.