

CODED

F. CLARK
WATER WELL DRILLING

MISSISSIPPI BOARD OF WATER COMMISSIONERS
ROUTE 2
416 North State Street
JACKSON, MISSISSIPPI 39201
LAUREL, MISS. 39440

Wayne
Q 24
7-9-75

WATER WELL DRILLERS LOG

719 1975 C.P. Clark Wayne
date well completed firm name county well located

LANDOWNER:	description of formations encountered	from	to
City's Airworth Rt #4 Laurel, Miss (mailing address)			
WELL LOCATION:			
sec. 23 T. 7(N) R. 9 E 3 1/2 miles SE of Strongland (distance) (direction) (nearest town)			
WELL PURPOSE: (home, irrigation, municipal, industrial)			
WELL COMPLETION DATA:			
(1) diameter (inches) 2			
(2) total depth (feet) 136			
(3) static water level (feet) 25 below top of ground.			
(4) casing Galv Iron 131 (material) (depth)			
(size) If telescope see back.			
(5) screen 5 131 (length) (depth to top)			
1/4 2.5 .006 (size) (material)			
(6) pump 1/2 12 (HP) (yield gpm)			
R.E.A. v (type power)			
(7) electric log No (yes or no)			
(organization running log)			
(8) how well bottom plugged Bw v			
DRILLERS REMARKS: Used Customer Pump Set 12A bit			




AUG 18 1975

MISS. Bd. OF WATER COMMISSIONERS

If well telescopes please sketch and show depths.

GROUND LEVEL

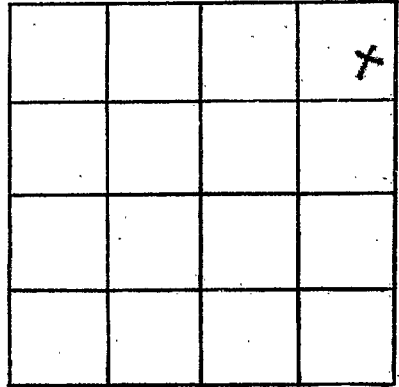

SECTION 23

Please indicate well location X.

ADDITIONAL INFORMATION

If more than one screen, show locations of each on sketch.