

MISSISSIPPI DEPARTMENT OF NATURAL RESOURCES

Bureau of Land and Water Resources

Southport Mall

P.O. Box 10631

Jackson, Mississippi 39209

WATER WELL DRILLERS LOG

WAYNE
Q 31
1/14/83

Griner Drilling Service, Inc.

Wayne

date well completed

firm name

county well located

LANDOWNER:	description of formations encountered	from	to
Osborn Heirs Co. 8700 Crownhill Suite 300 San Antonio, TX.	clay	0	72
WELL LOCATION: 100' N & 760' W 15 T 7 N R 9 E SE 1/4 Strickland Thompson Strickland Thompson Strickland Thompson	sand	72	84
WELL PURPOSE: oil field supply (home, irrigation, municipal, industrial)	clay	84	251
WELL COMPLETION DATA:	sand	251	294
(1) diameter (inches) 4"			
(2) total depth (feet) 315'			
(3) static water level (feet) 80' below top of ground.			
(4) casing steel 294' (material), (depth) 4" (size) if telescope see back.			
(5) screen 42' (length), 252' (depth to top) 4" perforated (size), (material)			
(6) pump AC (type power), 75 (yield gpm)			
(7) electric log (yes or no)			
(organization running log)			
(8) how well bottom plugged orange peel			
DRILLERS REMARKS:			

CODED


DEPT. OF NATURAL RESOURCES
BUREAU OF LAND & WATER RESOURCES

JAN 24 1983

RECEIVED

If well telescopes please sketch and show depths.

GROUND LEVEL

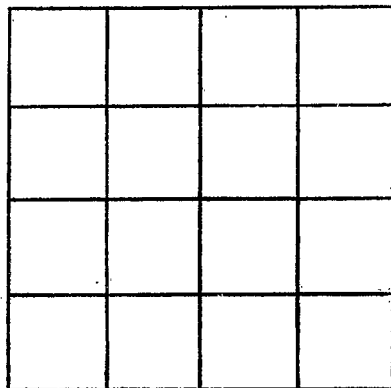

SECTION _____

Please indicate well location X.

ADDITIONAL INFORMATION

If more than one screen,
show locations of each on sketch.