

MISSISSIPPI DEPARTMENT OF NATURAL RESOURCES

Bureau of Land and Water Resources

Southport Mall

P.O. Box 10631

Jackson, Mississippi 39209

WATER WELL DRILLERS LOG

CODED

Griner Drilling Service, Inc.

Wayne

WAYNE
Q 32
4/7/83

47-83

date well completed

firm name

county well located

LANDOWNER:

Osborn Heirs Co.
P.O. Box 17968
San Antonio, TX 78286
(mailing address)

description of formations encountered

from

to

clay, lime rock 0 279

SAND 279 302

WELL LOCATION: 1445' N 4125' W

sec. 15 T 70 N R 9 E S4100'

clay, lime rock 302 371

No. 3 # Thompson Oil Field
Death Valley (nearest town)

WELL PURPOSE: oilfield supply
(home, irrigation, municipal, industrial)

WELL COMPLETION DATA:

(1) diameter (inches) 4"

(2) total depth (feet) 371'

(3) static water level (feet) 40' below top of ground.

(4) casing Steel 375' (material) (depth)

4" (size) if telescope see back.

(5) screen 42' 273' (length) (depth to top)

4" perforated (size) (material)

(6) pump 75 (HP) (yield gpm)

AC (type power)

(7) electric log (yes or no)

(organization running log)

(8) how well bottom plugged orange

peel

DRILLERS REMARKS:

CODED


DEPT. OF NATURAL RESOURCES
BUREAU OF LAND & WATER RESOURCES

MAY 16 1983

RECEIVED

If well telescopes please sketch and show depths.

GROUND LEVEL

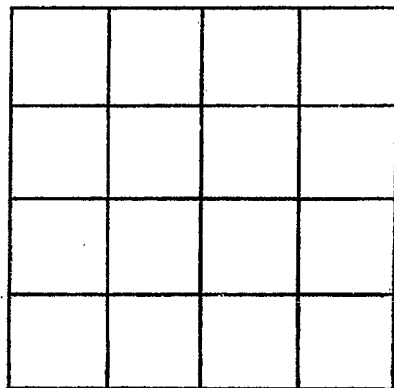

SECTION _____

Please indicate well location X.

ADDITIONAL INFORMATION

If more than one screen,
show locations of each on sketch.