

MISSISSIPPI DEPARTMENT OF NATURAL RESOURCES

Bureau of Land and Water Resources

Southport Mall

P.O. Box 10631

Jackson, Mississippi 39209

WATER WELL DRILLERS LOG

CODED

WAYNE
Q 33
7/13/83

Griner Drilling Service, Inc.

Wayne

7-13-83
date well completed

firm name

county well located

LANDOWNER:
Osborn Heirs Co.
P.O. Box 17968
San Antonio, Tx. 78286
(mailing address)

| description of formations encountered | from | to |
|---------------------------------------|------|-----|
| chalk | 0 | 70 |
| sand, gravel | 70 | 105 |
| chalk | 105 | 273 |
| streaked | 273 | 294 |
| sand | 294 | 336 |
| sand, rock, chalk | 336 | 357 |

WELL LOCATION: 125N4 125W
sec. 15 T-7N R-9 E SE/4
Dr. H. Jones Thomason Creek
C.H. (distance) (direction) (nearest town)

WELL PURPOSE:
(home, irrigation, municipal, industrial)

WELL COMPLETION DATA:

(1) diameter (inches) 4"

(2) total depth (feet) 357'

(3) static water level (feet) 40' below top of ground.

(4) casing Steel 357' (material) (depth)
4" (size) if telescope see back.

(5) screen 42' 315' (length) (depth to top)
4" perforated (size) (material)

(6) pump — 80 (HP) (yield gpm)
AC (type power)

(7) electric log (yes or no)

(organization running log)

(8) how well bottom plugged Orange peel

DRILLERS REMARKS:

CODED


DEPT. OF NATURAL RESOURCES
BUREAU OF LAND & WATER RESOURCES

AUG 4 1983

RECEIVED

If well telescopes please
sketch and show depths.

GROUND LEVEL

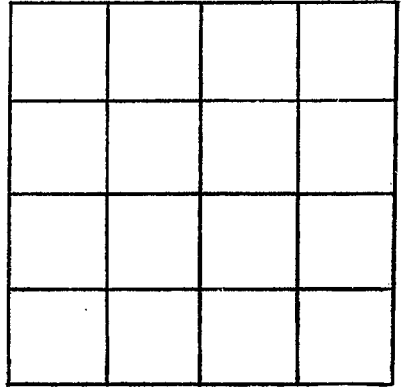

SECTION _____

Please indicate well location X.

ADDITIONAL INFORMATION

If more than one screen,
show locations of each on sketch.